




1 SECOND FLOOR REFLECTED CEILING PLAN
3/8"=1'-0"
A2403

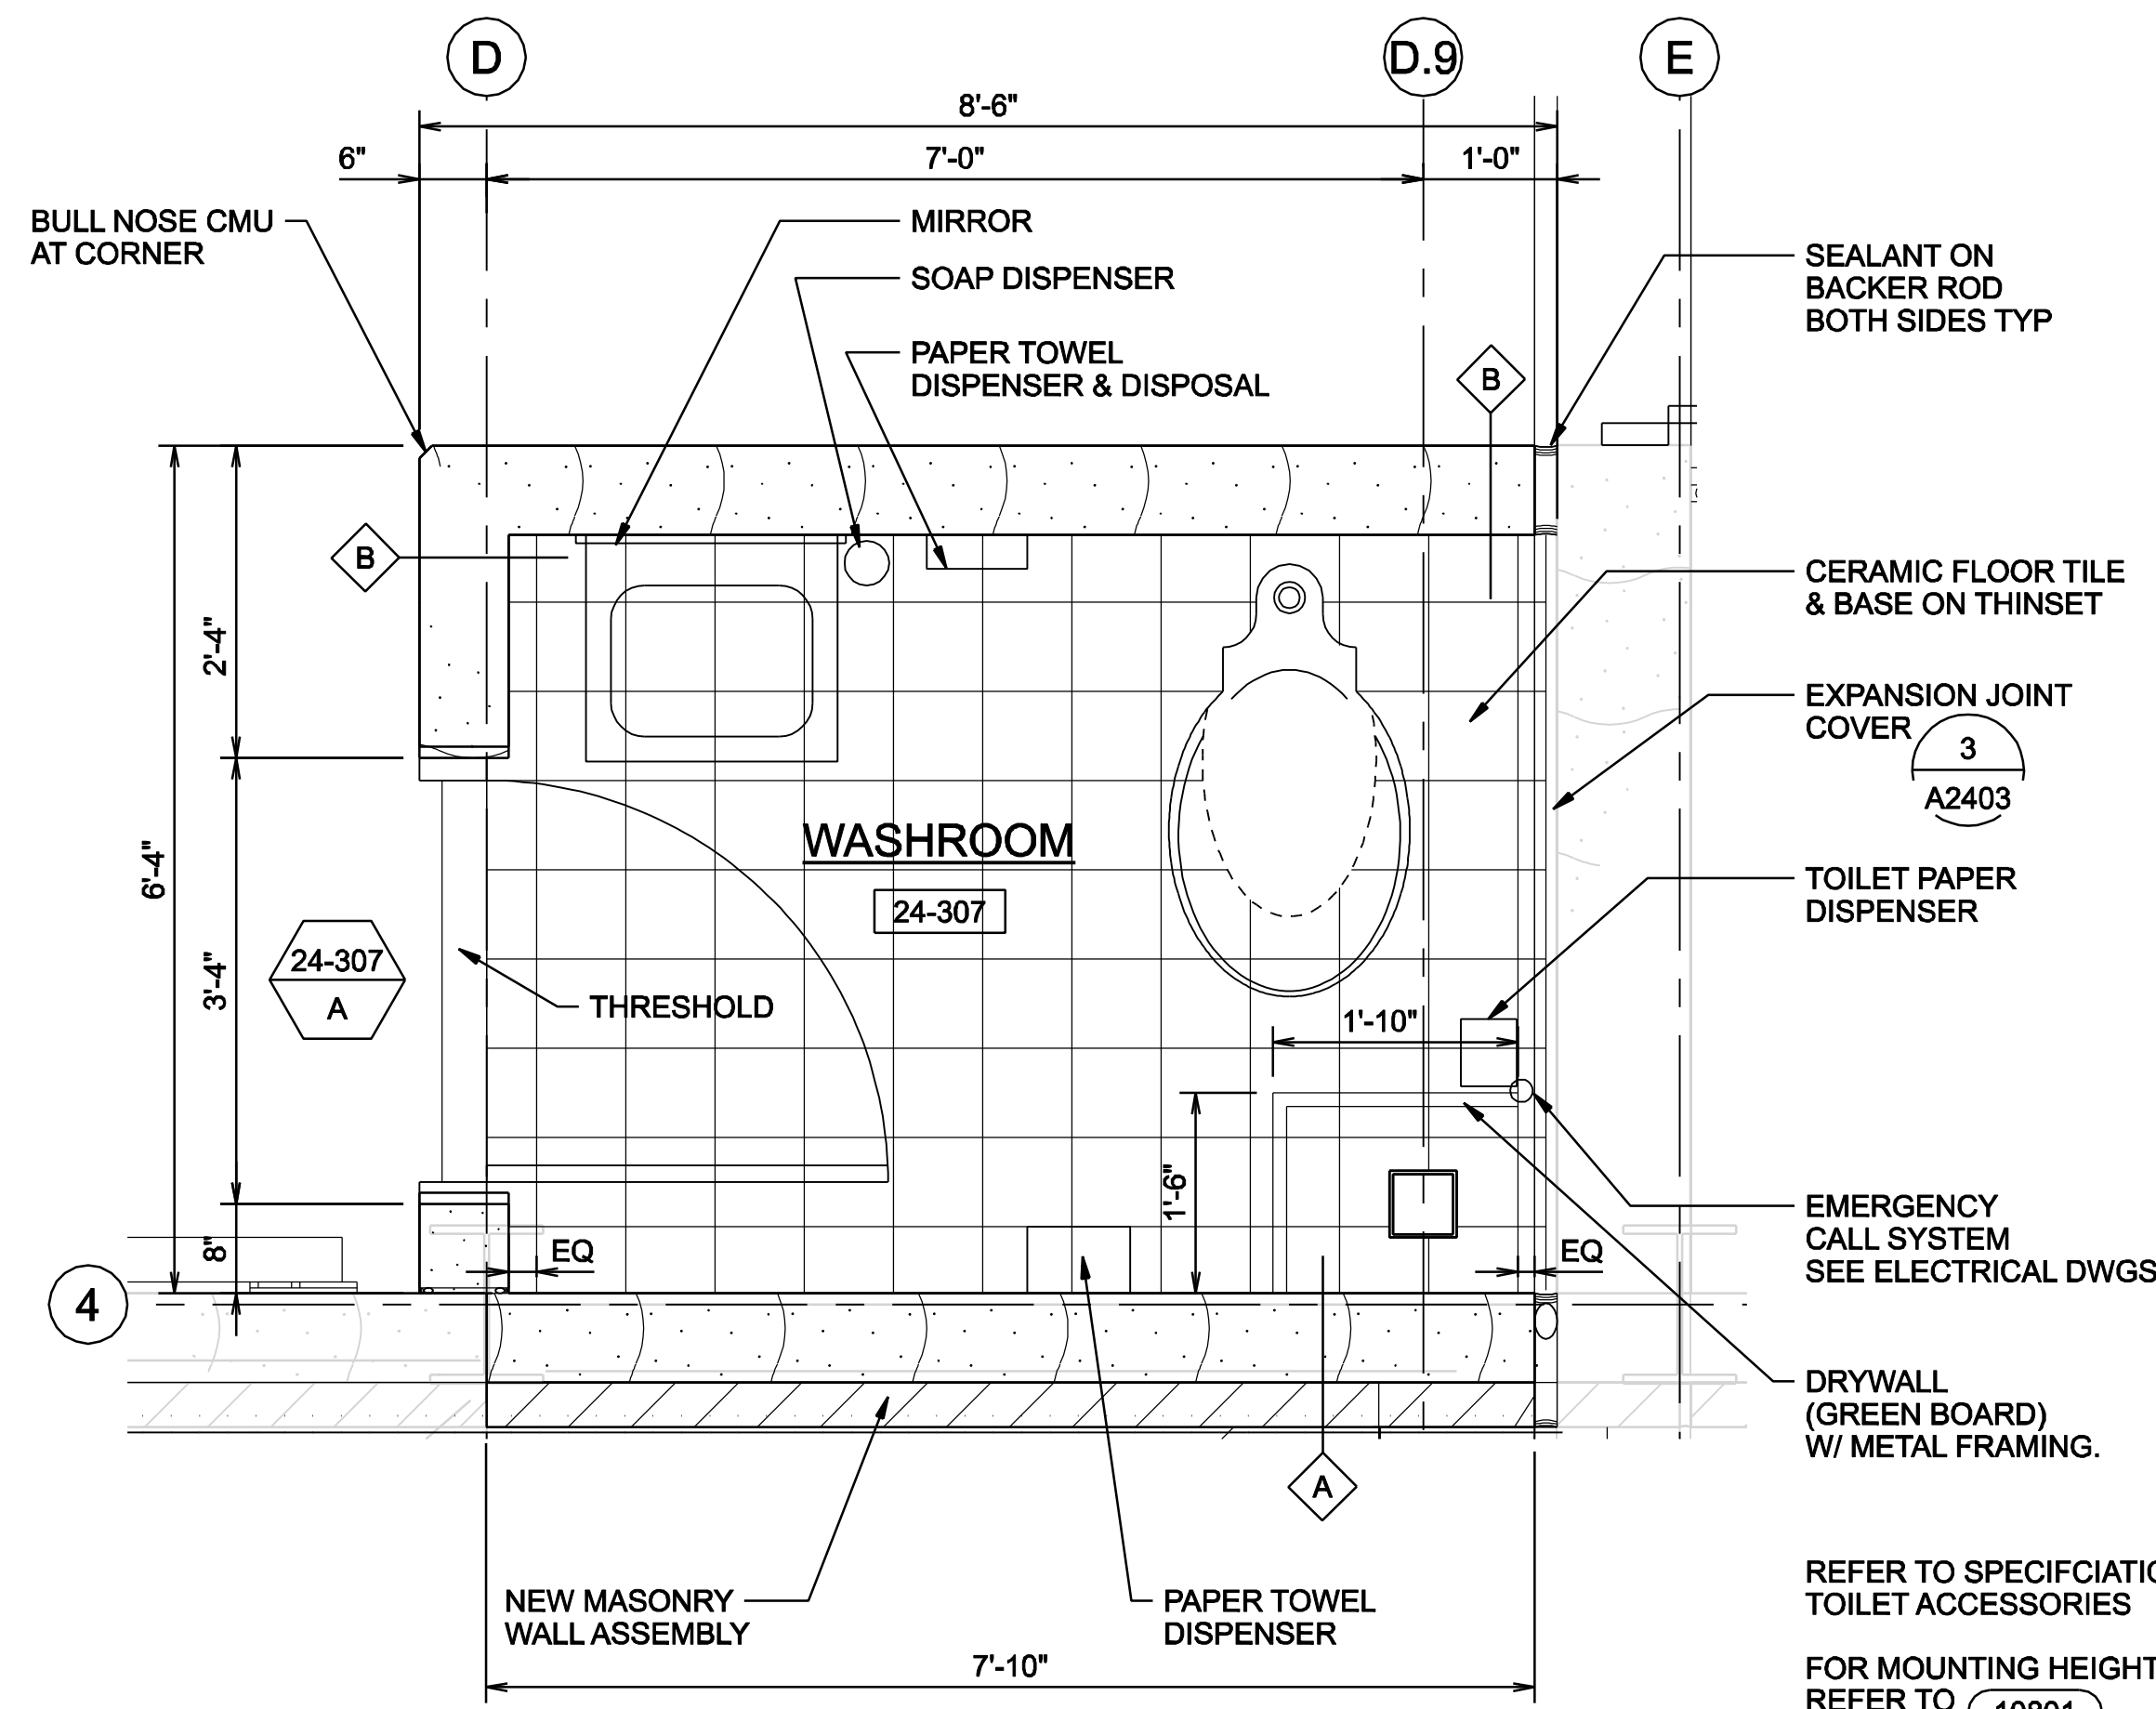

2 WASHROOM FLOOR PLAN
3/4"=1'-0"
A2401

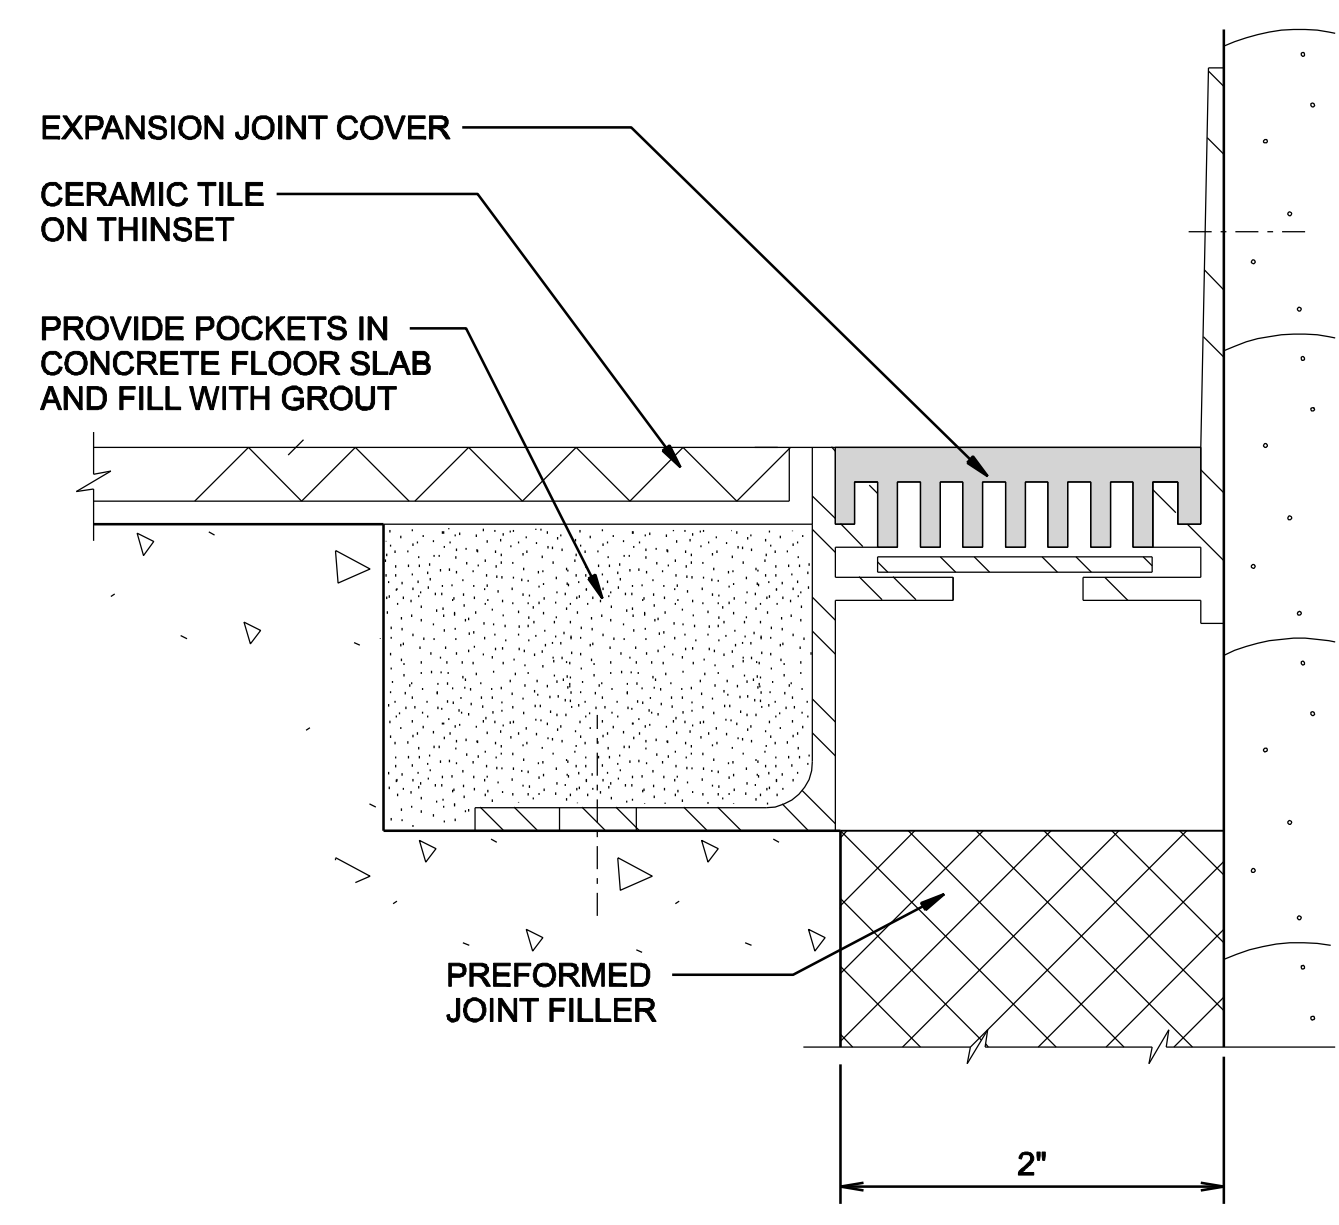

3 FLOOR TO WALL EXPANSION JOINT COVER
NTS

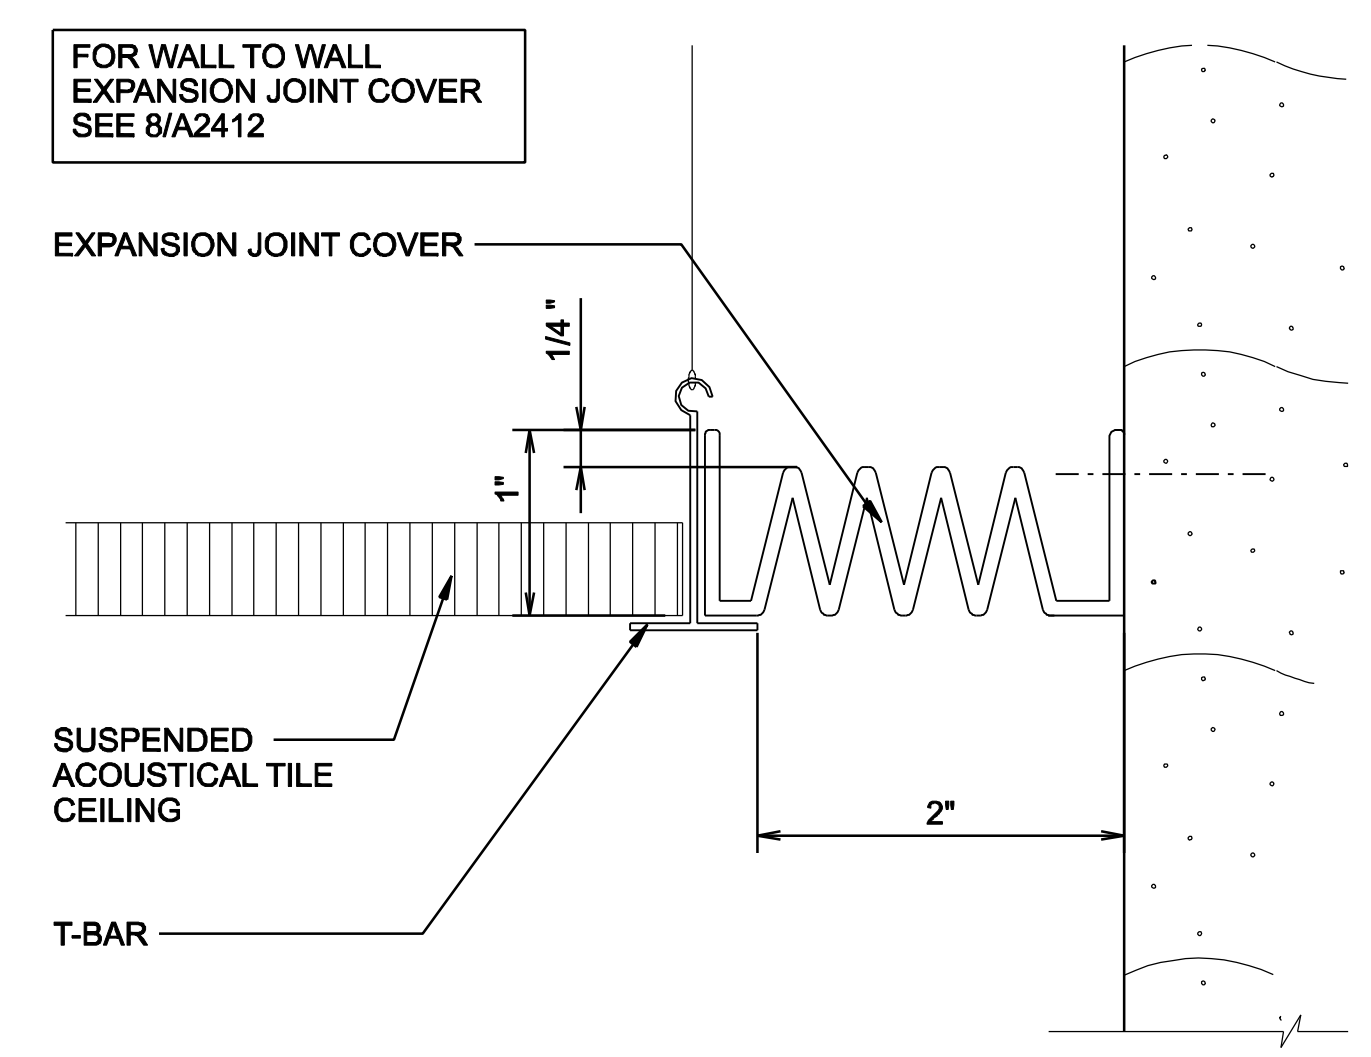

4 CEILING TO WALL EXPANSION JOINT COVER
NTS

THESE RECORD DOCUMENTS HAVE BEEN PREPARED BASED ON THE INFORMATION PROVIDED BY OTHERS. THE DESIGN PROFESSIONAL HAS NOT VERIFIED THE ACCURACY AND/OR COMPLETENESS OF THIS INFORMATION AND SHALL NOT BE RESPONSIBLE FOR ANY ERRORS OR OMISSIONS WHICH MAY BE INCORPORATED HEREIN AS A RESULT.

| | | | |
|--|--------------------------------|---|---|
| | | STAMFORD WATER POLLUTION CONTROL AUTHORITY SOLIDS DRYING PROJECT | |
| | | ARCHITECTURAL REFLECTED CEILING WC PLAN & PLANS | |
| RECORD DRAWING RE-ISSUED FOR CONSTRUCTION ISSUED FOR CONSTRUCTION FOR FINAL REVIEW/ BUILDING PERMIT | NO. 3 DATE 01/20/08 DSGN | REVISION 1 09/08/06 2 07/04/06 3 06/05/06 | WYU LGRANDE WYU B GACKSTATTER DR APVD BY APVD |
| VERIFY SCALE BAR IS ONE INCH ON ORIGINAL DRAWING. | | DATE JUNE 2006 PROJ 334058 DWG A-2403 SHEET A6 | © CH2M HILL 2004. ALL RIGHTS RESERVED. REUSE OF DOCUMENTS: THIS DOCUMENT AND THE IDEAS AND DESIGNS INCORPORATED HEREIN, AS AN INSTRUMENT OF PROFESSIONAL SERVICE, IS THE PROPERTY OF CH2M HILL AND IS NOT TO BE USED, IN WHOLE OR IN PART, FOR ANY OTHER PROJECT WITHOUT THE WRITTEN AUTHORIZATION OF CH2M HILL. |