

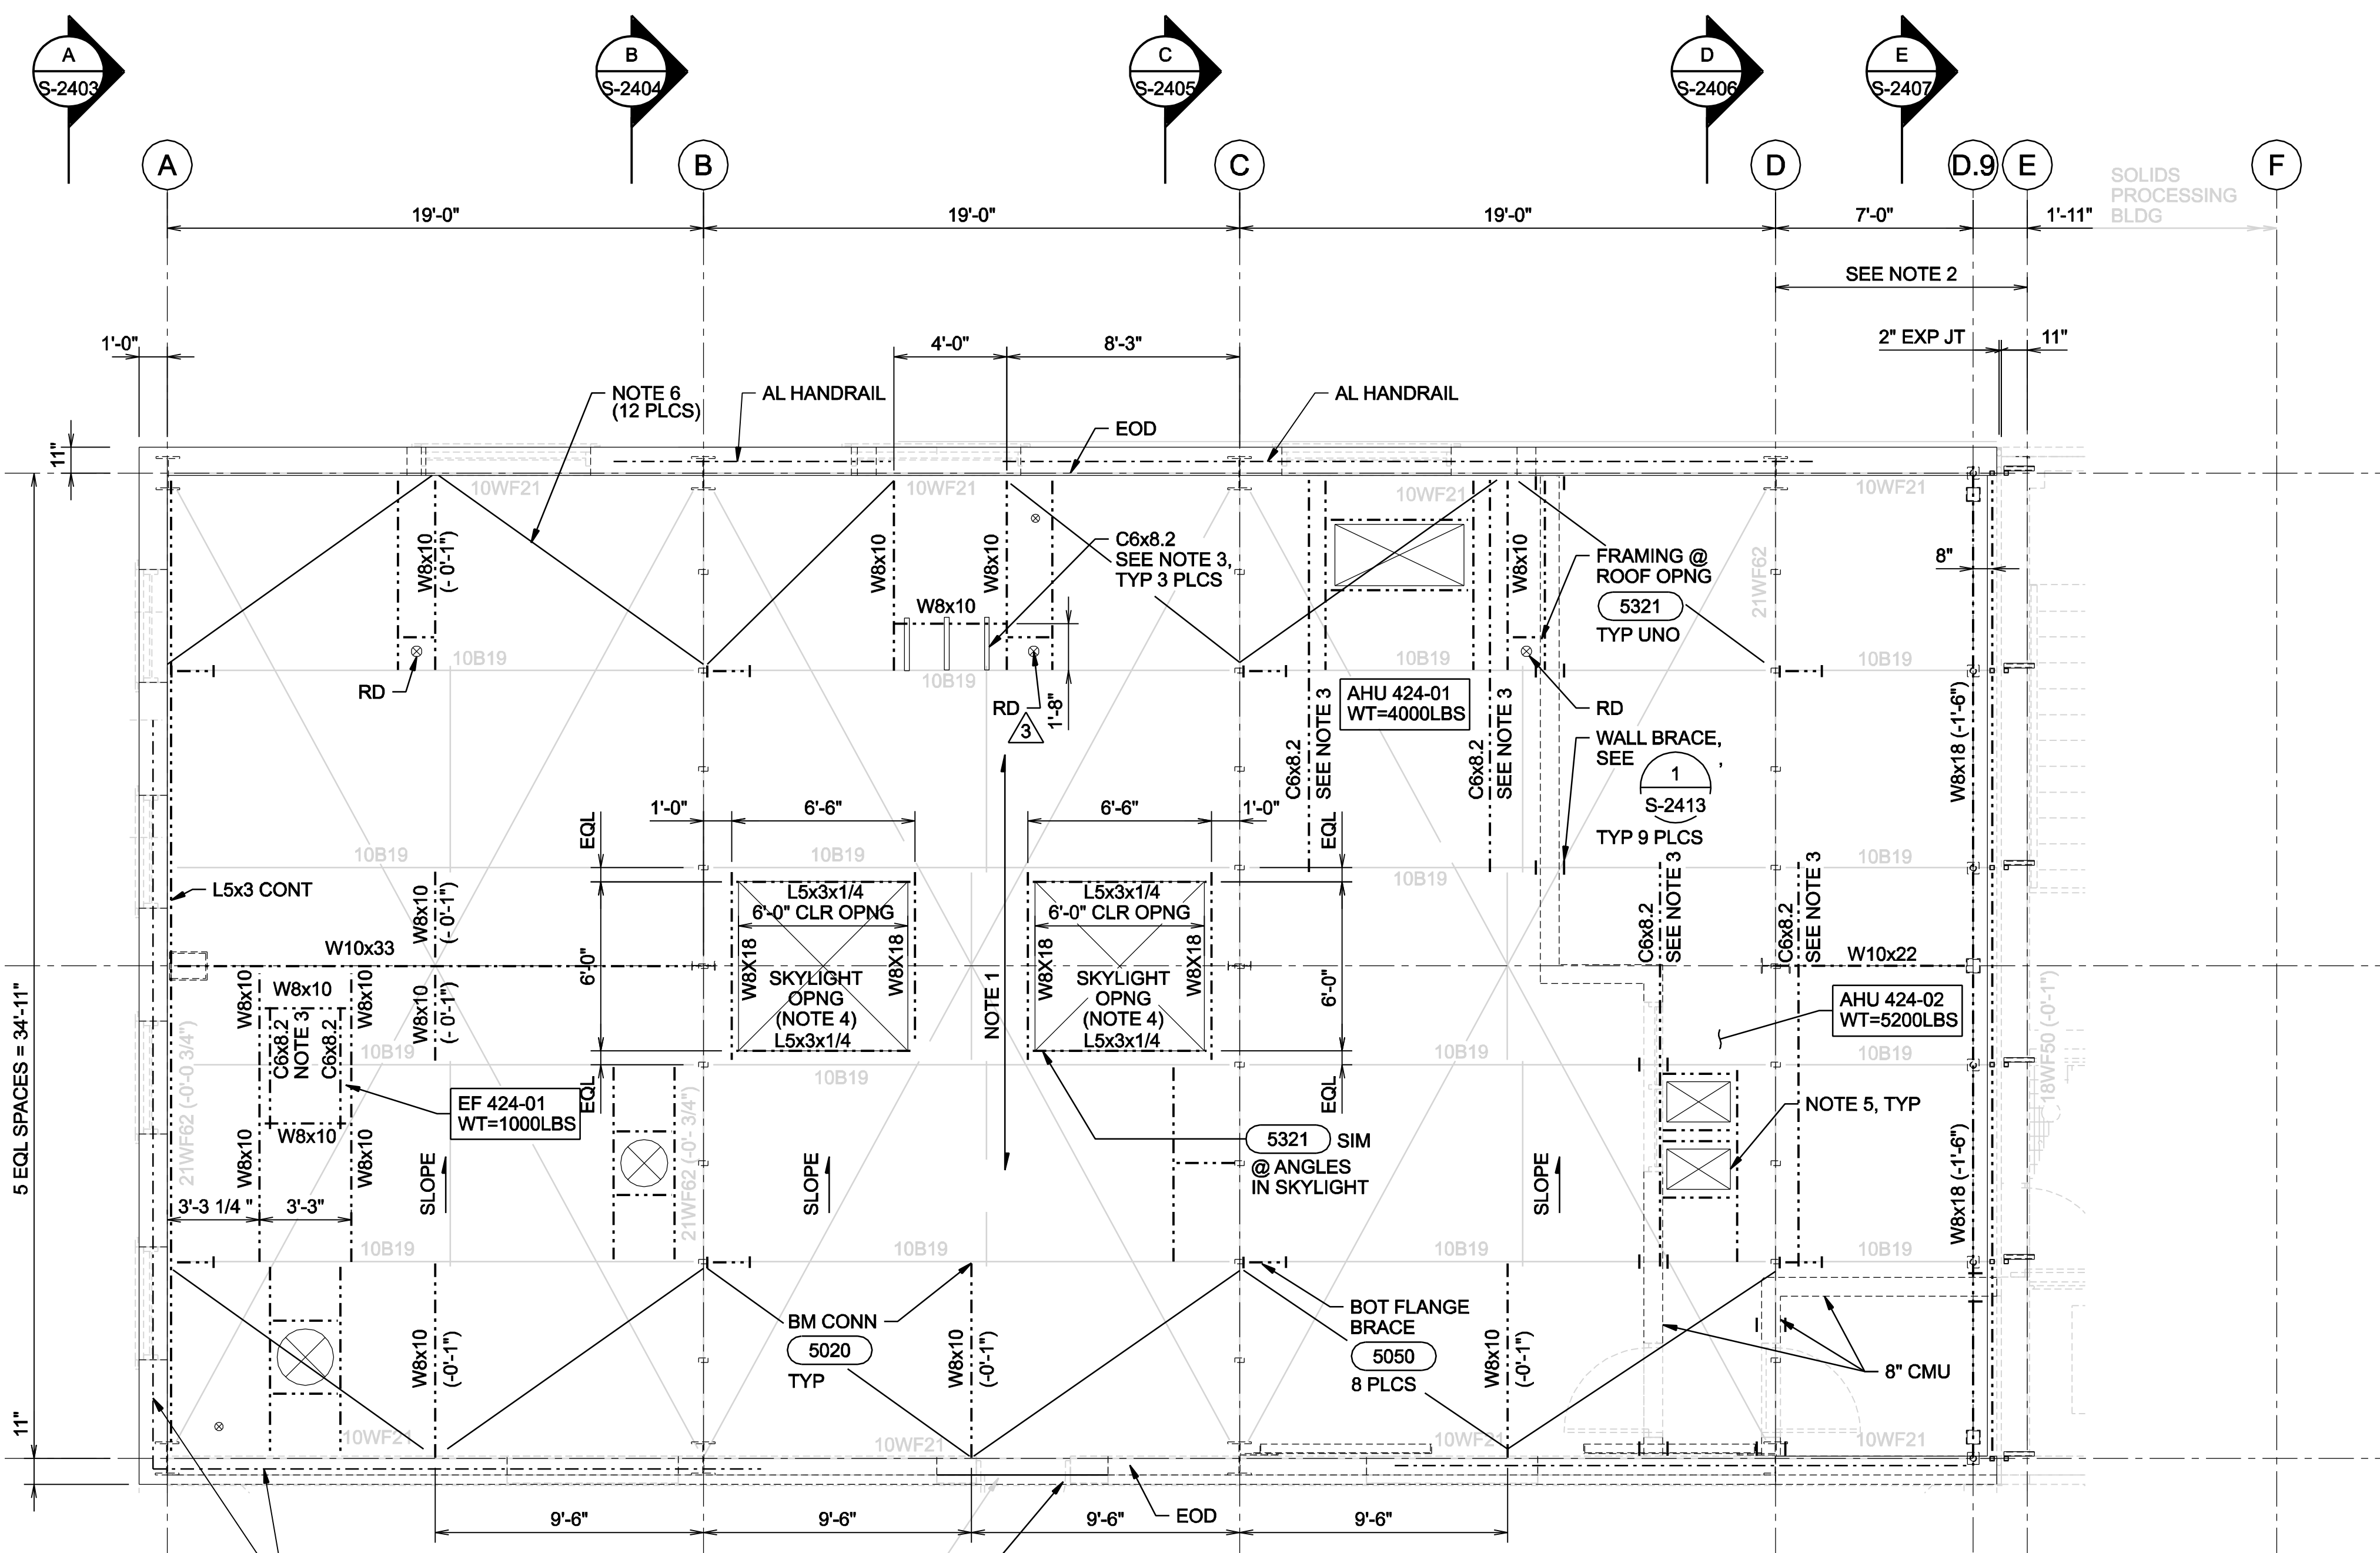
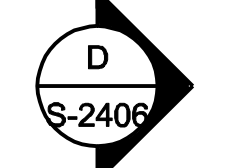
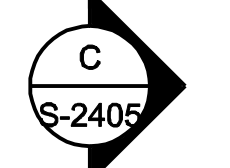
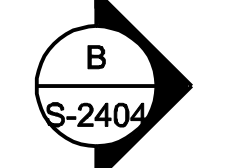
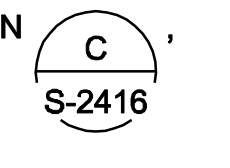
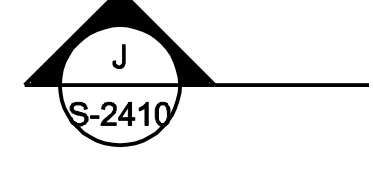


1 2 3 4 5 6

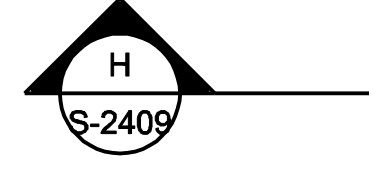

CONTRACTOR TO FIELD VERIFY ALL DIMENSIONS PRIOR TO INITIATING ANY DEMOLITION OR OTHER WORK INCLUDING ORDERING MATERIALS.

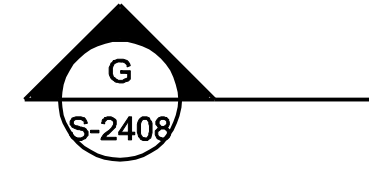

HIGH ROOF PLAN

1/4"=1'-0"

- NOTES:**
- NEW ROOF CONSTRUCTION:
1 1/2" B x 18 GA GALVANIZED STEEL DECK. CONNECT DECK TO STRUCTURAL STEEL USING 5/8" DIA SPOT WELDS AT A 3/4 WELD PATTERN UNLESS NOTED. USE A 3/8" WELD PATTERN FOR DECK WITHIN 7'-0" OF COLUMN LINES A, E, 2 AND 4. WELD DECK TO PARRALLEL SUPPORT STEEL AT 12" OC. PROVIDE #12 SELF-DRILLING MECHANICAL SIDE LAP FASTENERS SPACED AT 28" OC MAXIMUM.
 - REMOVE EXISTING DIAGONAL BRACING BETWEEN GRID (D) AND (E) AFTER ALL ROOF DECKS ARE FASTENED TO FRAMING.
 - SEE DETAIL S-2415.
 - SEE DETAIL S-2422 FOR SKYLIGHT CURB FRAMING.
 - COORDINATE LOCATION OF FRAMING AROUND OPENINGS BASED ON APPROVED EQUIPMENT SHOP DRAWINGS.
 - PROVIDE TEMPORARY L 4" x 4" x 3/8" BRACING ^ JUST ABOVE BOTTOM FLANGE OF W10s UNTIL ROOF DECK IS INSTALLED. WELD TO EA LEG OF ANGLE TO W10 WITH 1/4" x 2" FILLET WELD

THESE RECORD DOCUMENTS HAVE BEEN PREPARED BASED ON THE INFORMATION PROVIDED BY OTHERS. THE DESIGN PROFESSIONAL HAS NOT VERIFIED THE ACCURACY AND/OR COMPLETENESS OF THIS INFORMATION AND SHALL NOT BE RESPONSIBLE FOR ANY ERRORS OR OMISSIONS WHICH MAY BE INCORPORATED HEREIN AS A RESULT.

 STAMFORD WATER POLLUTION CONTROL AUTHORITY SOLIDS DRYING PROJECT	RECORD DRAWING REVISIONS PER CCIR No. DR-16 RE-ISSUED FOR CONSTRUCTION ISSUED FOR CONSTRUCTION FOR FINAL REVIEW/ BUILDING PERMIT	BG BG BG MC BG	PW BG BG BG BG	APVD BY BG BG BG
		DATE NO.	DATE NO.	DATE NO.
CH2MHILL STRUCTURAL OVERALL HIGH ROOF PLAN	M. CHEZANOWSKI DSGN	G. OMORI DR	M. GOODSON CHK	B. GACKSTATTER APVD
VERIFY SCALE BAR IS ONE INCH ON ORIGINAL DRAWING.	DATE JUN 2006	PROJ 334058	DWG S-2402	SHEET S15

REUSE OF DOCUMENTS: THIS DOCUMENT AND THE IDEAS AND DESIGNS INCORPORATED HEREIN, AS AN INSTRUMENT OF PROFESSIONAL SERVICE, IS THE PROPERTY OF CH2M HILL AND IS NOT TO BE USED, IN WHOLE OR IN PART, FOR ANY OTHER PROJECT WITHOUT THE WRITTEN AUTHORIZATION OF CH2M HILL. © CH2M HILL 2004. ALL RIGHTS RESERVED.