



W1 AND W2 RISER DIAGRAM

NTS

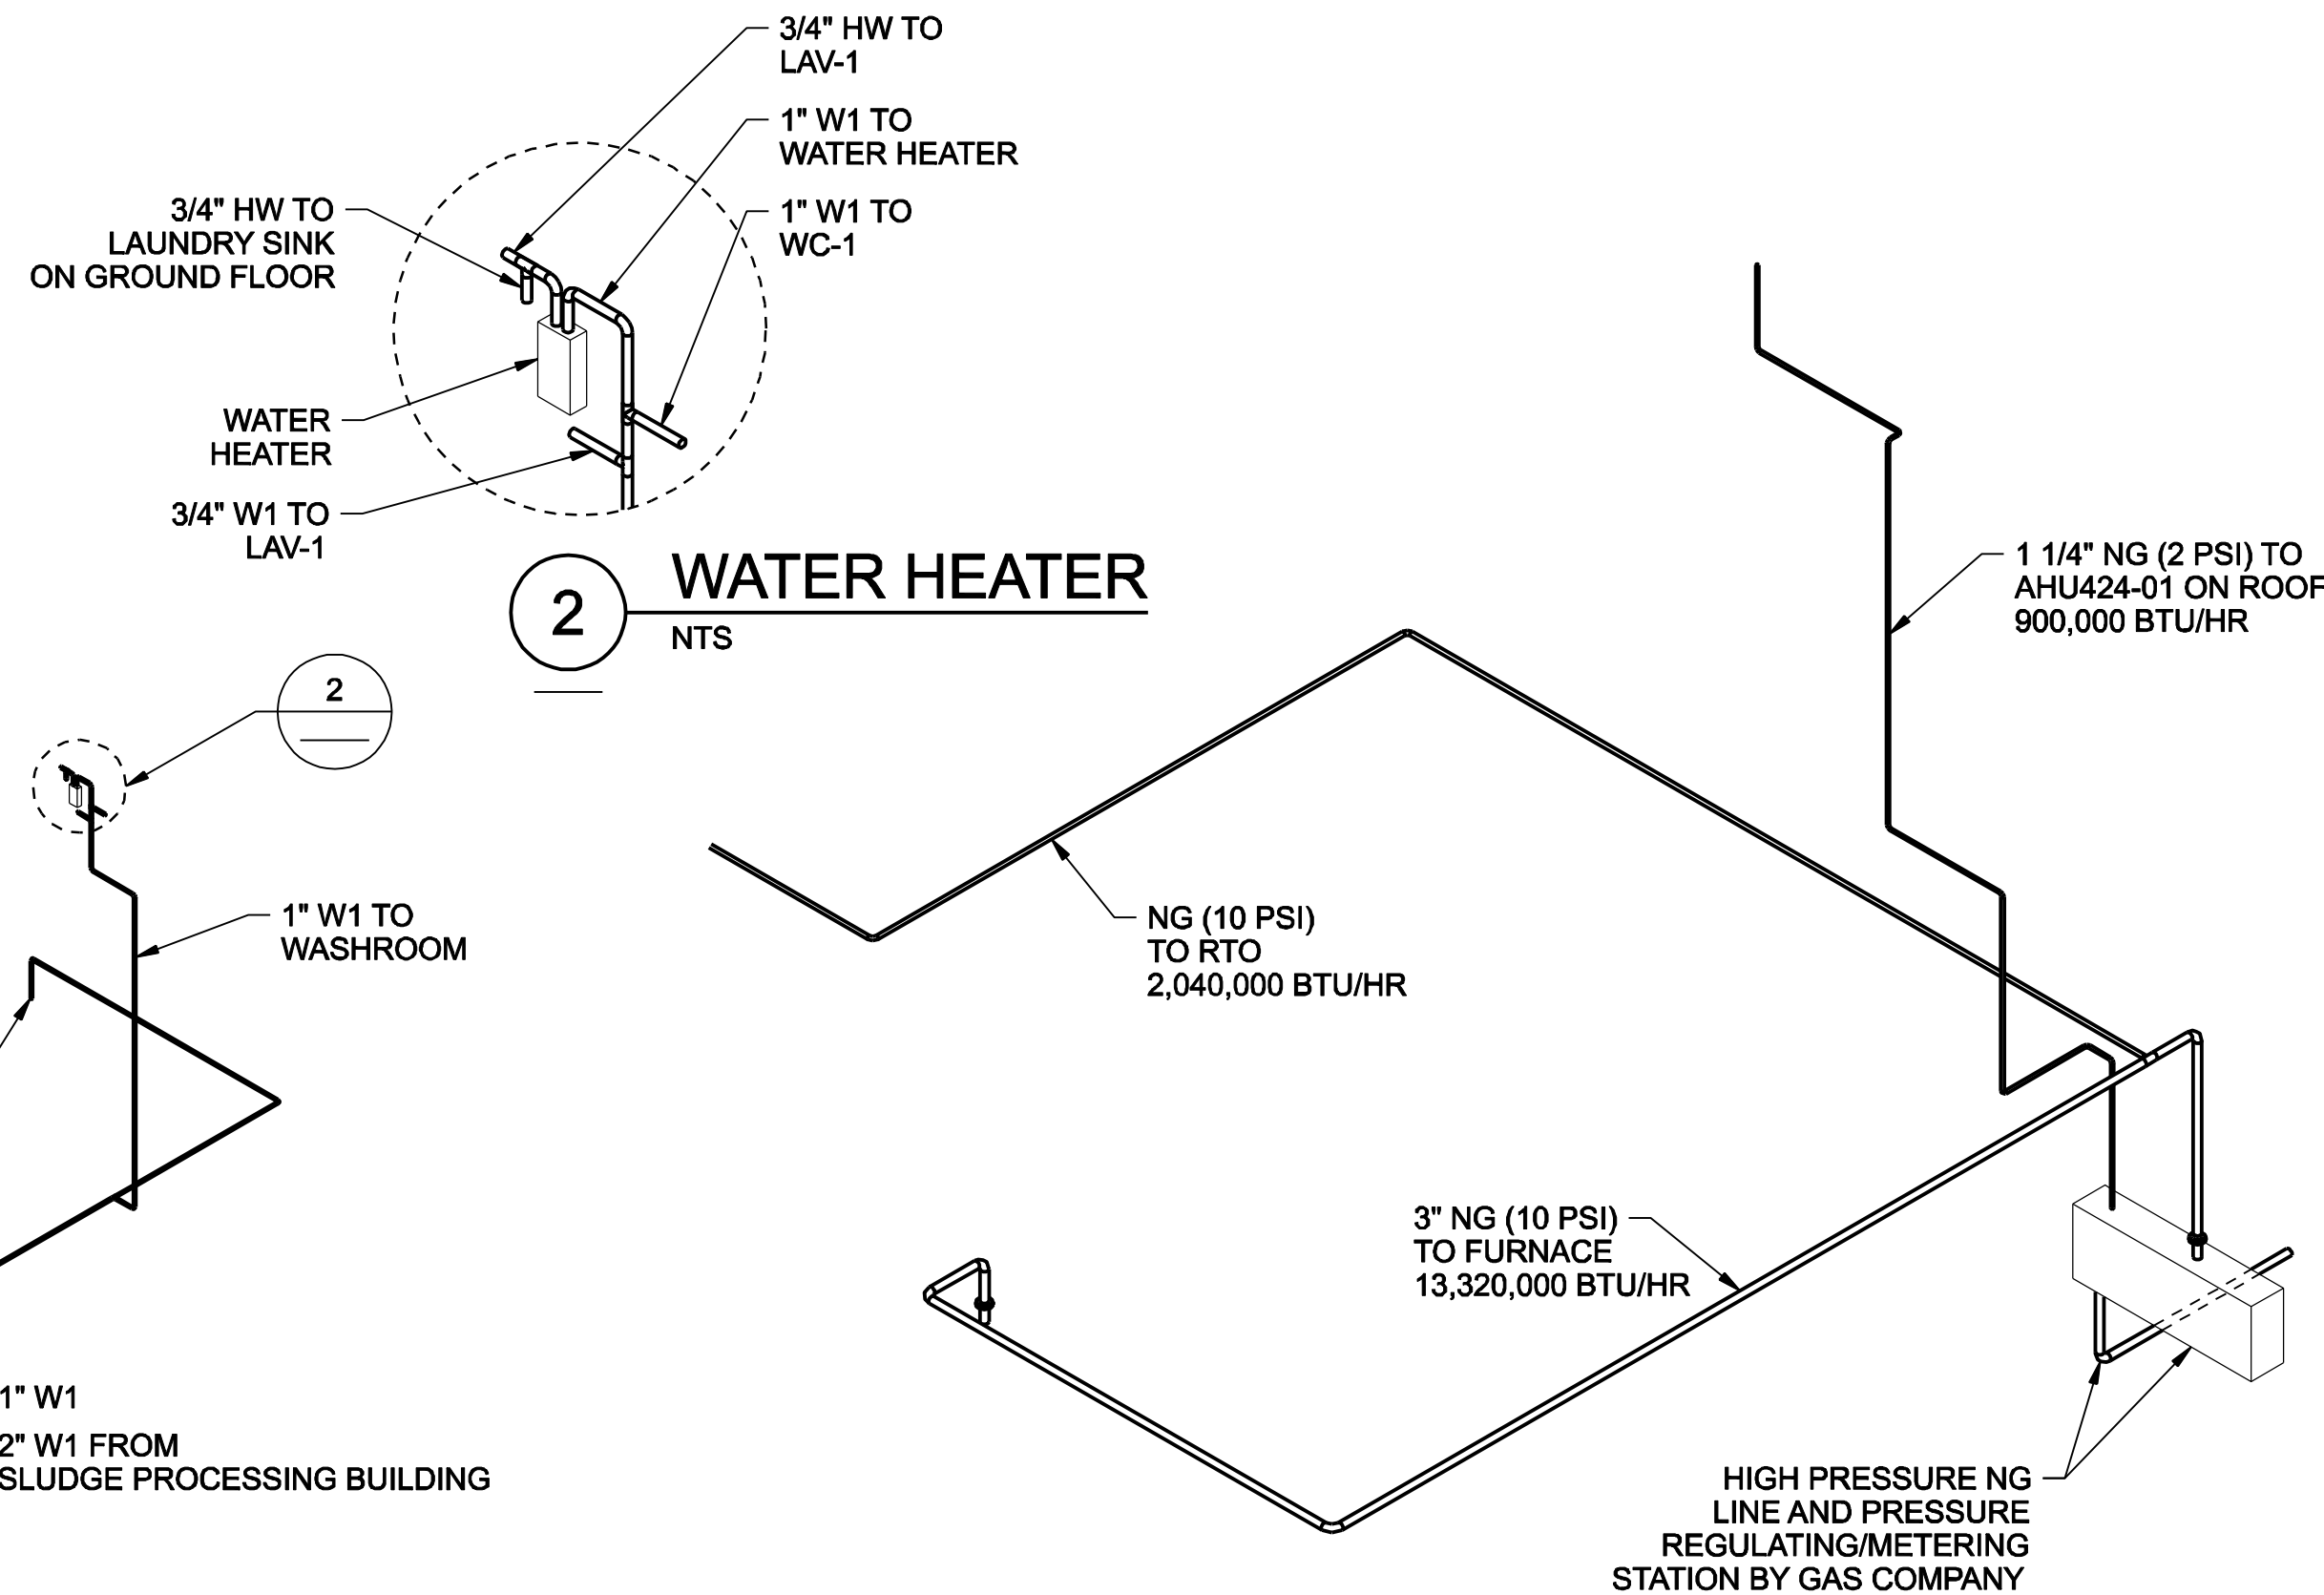


NATURAL GAS RISER DIAGRAM

NTS

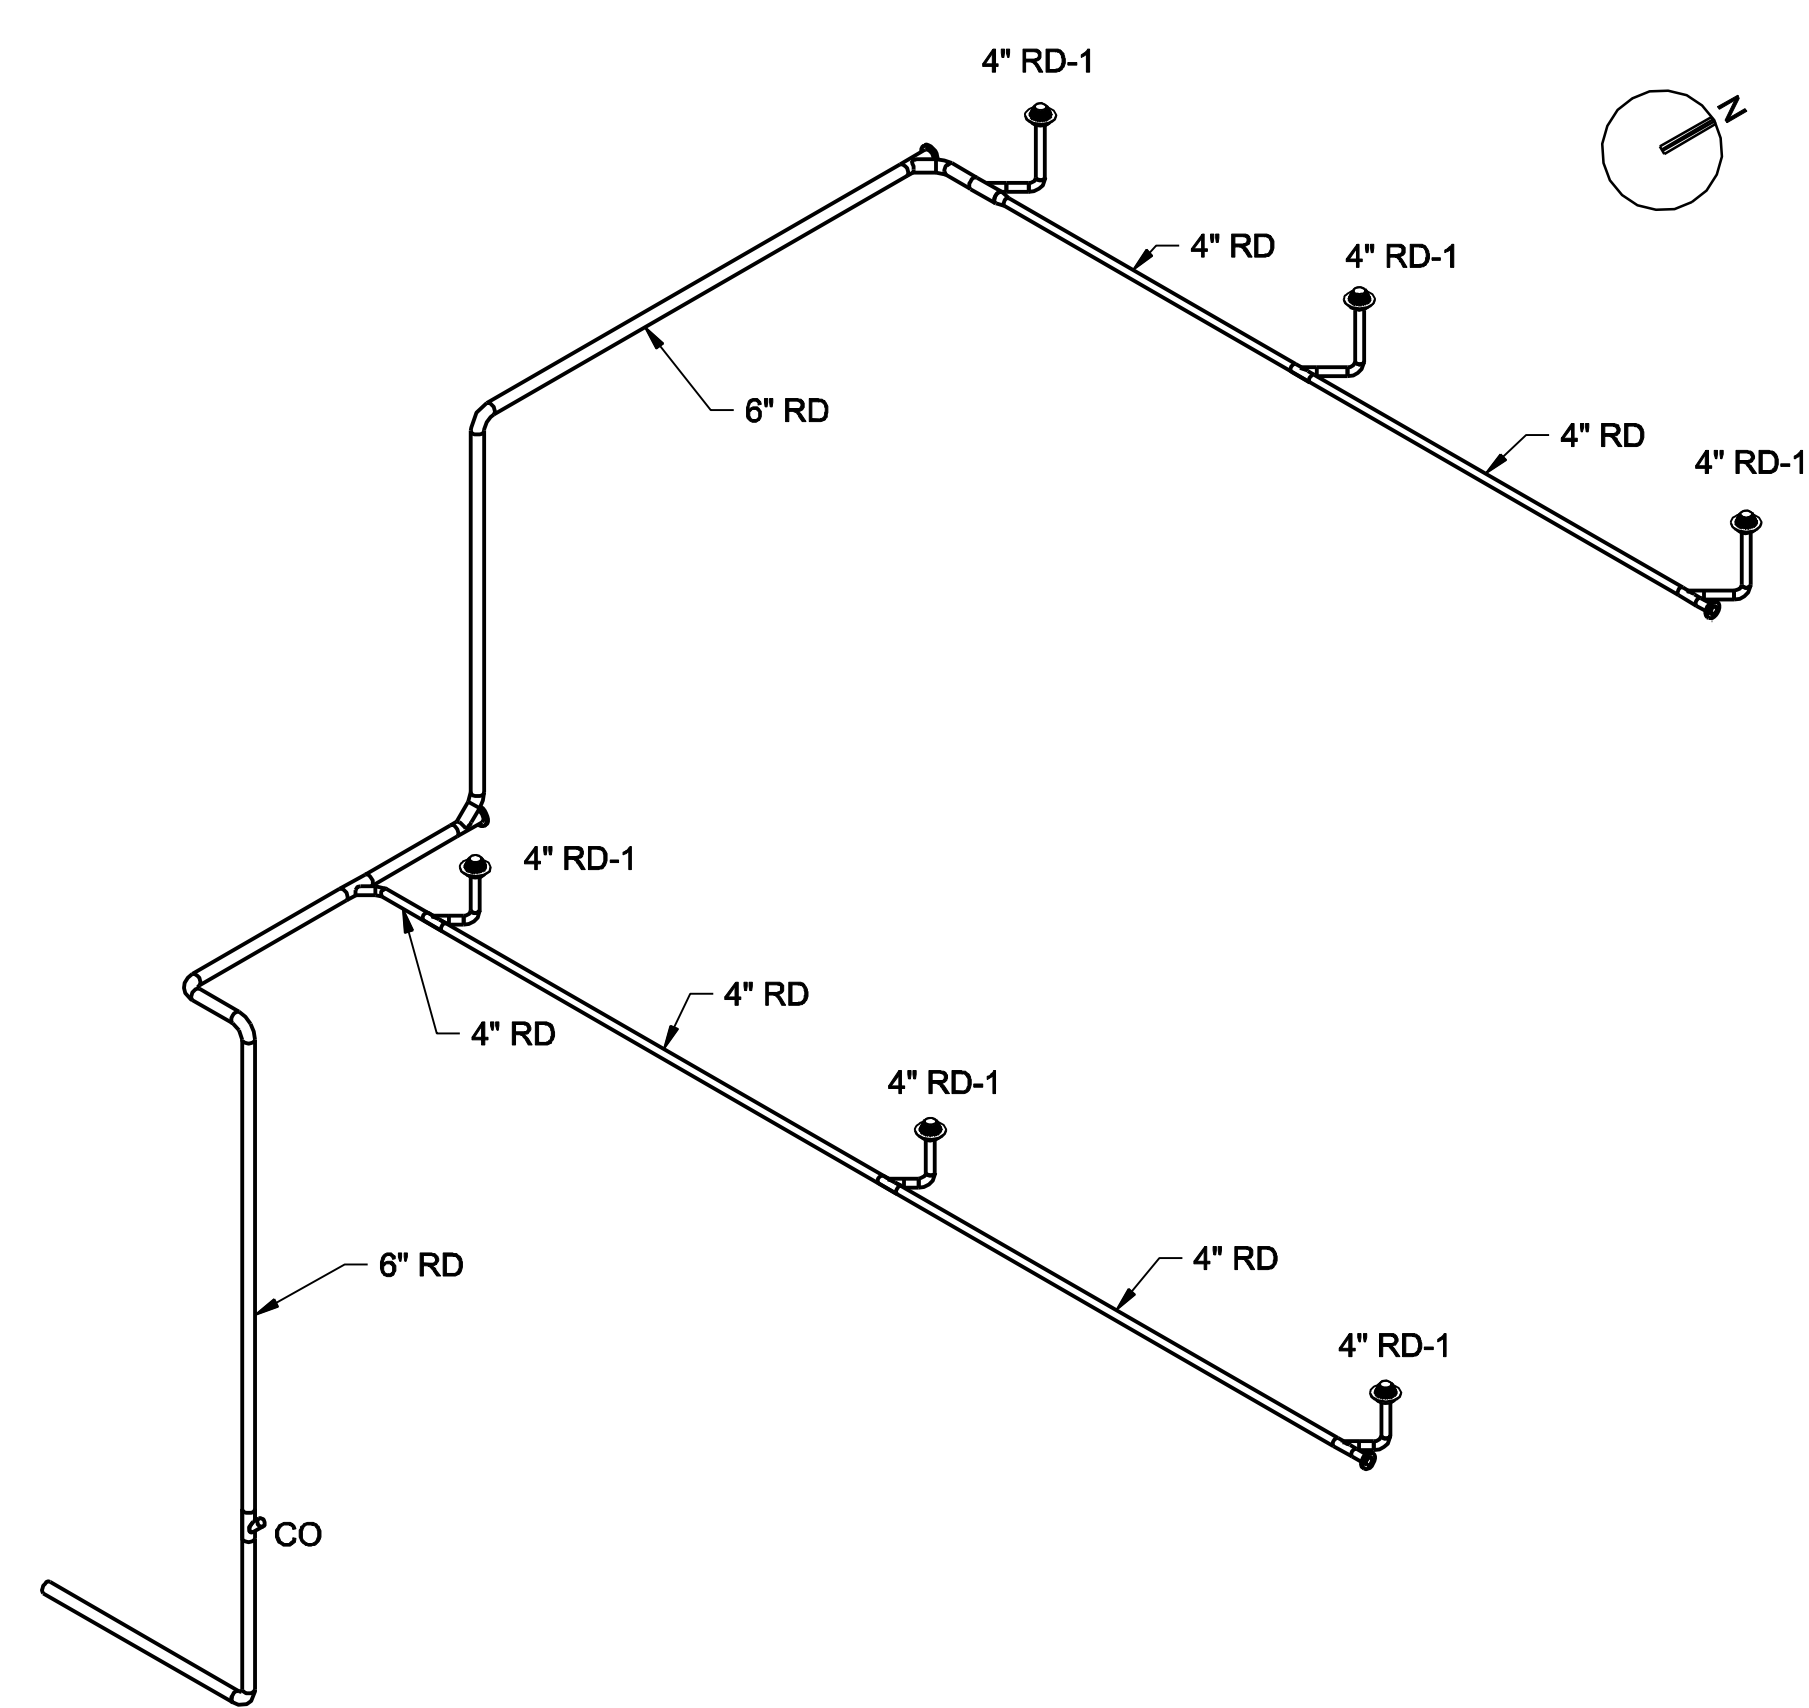

ROOF DRAINAGE RISER DIAGRAM

NTS

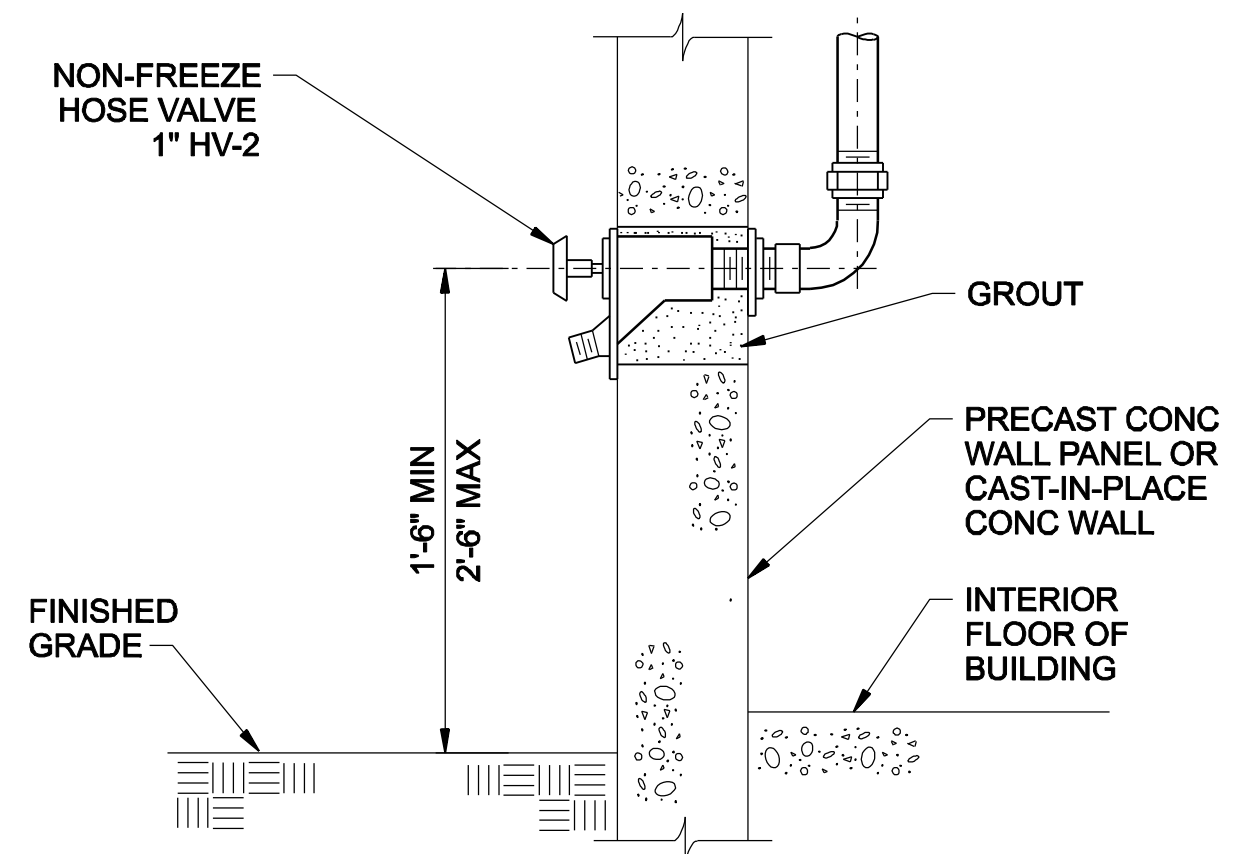


EXTERIOR HOSE VALVE

15155


NOTES:

- FOR THE PURPOSE OF DRAWING CLARITY, HOT WATER PIPING IS NOT SHOWN. FROM THE OUTLET OF THE TANKLESS HOT WATER HEATER, ROUTE 3/4" HW TO LAV-1 IN WASHROOM AND LAUNDRY SINK ON GROUND FLOOR.
- W2 CONNECTION TO ELECTRONIC TRAP PRIMER (ETP-1) AND TRAP PRIMER PIPING NOT SHOWN. ROUTE 1/2" W2 FROM GROUND FLOOR TO ETP-1 IN WASHROOM. PRIME FLOOR DRAINS MARKED FD-XP ON DWG P141 & P161 AND THE RUNNING TRAP INDICATED ON DWG M142.

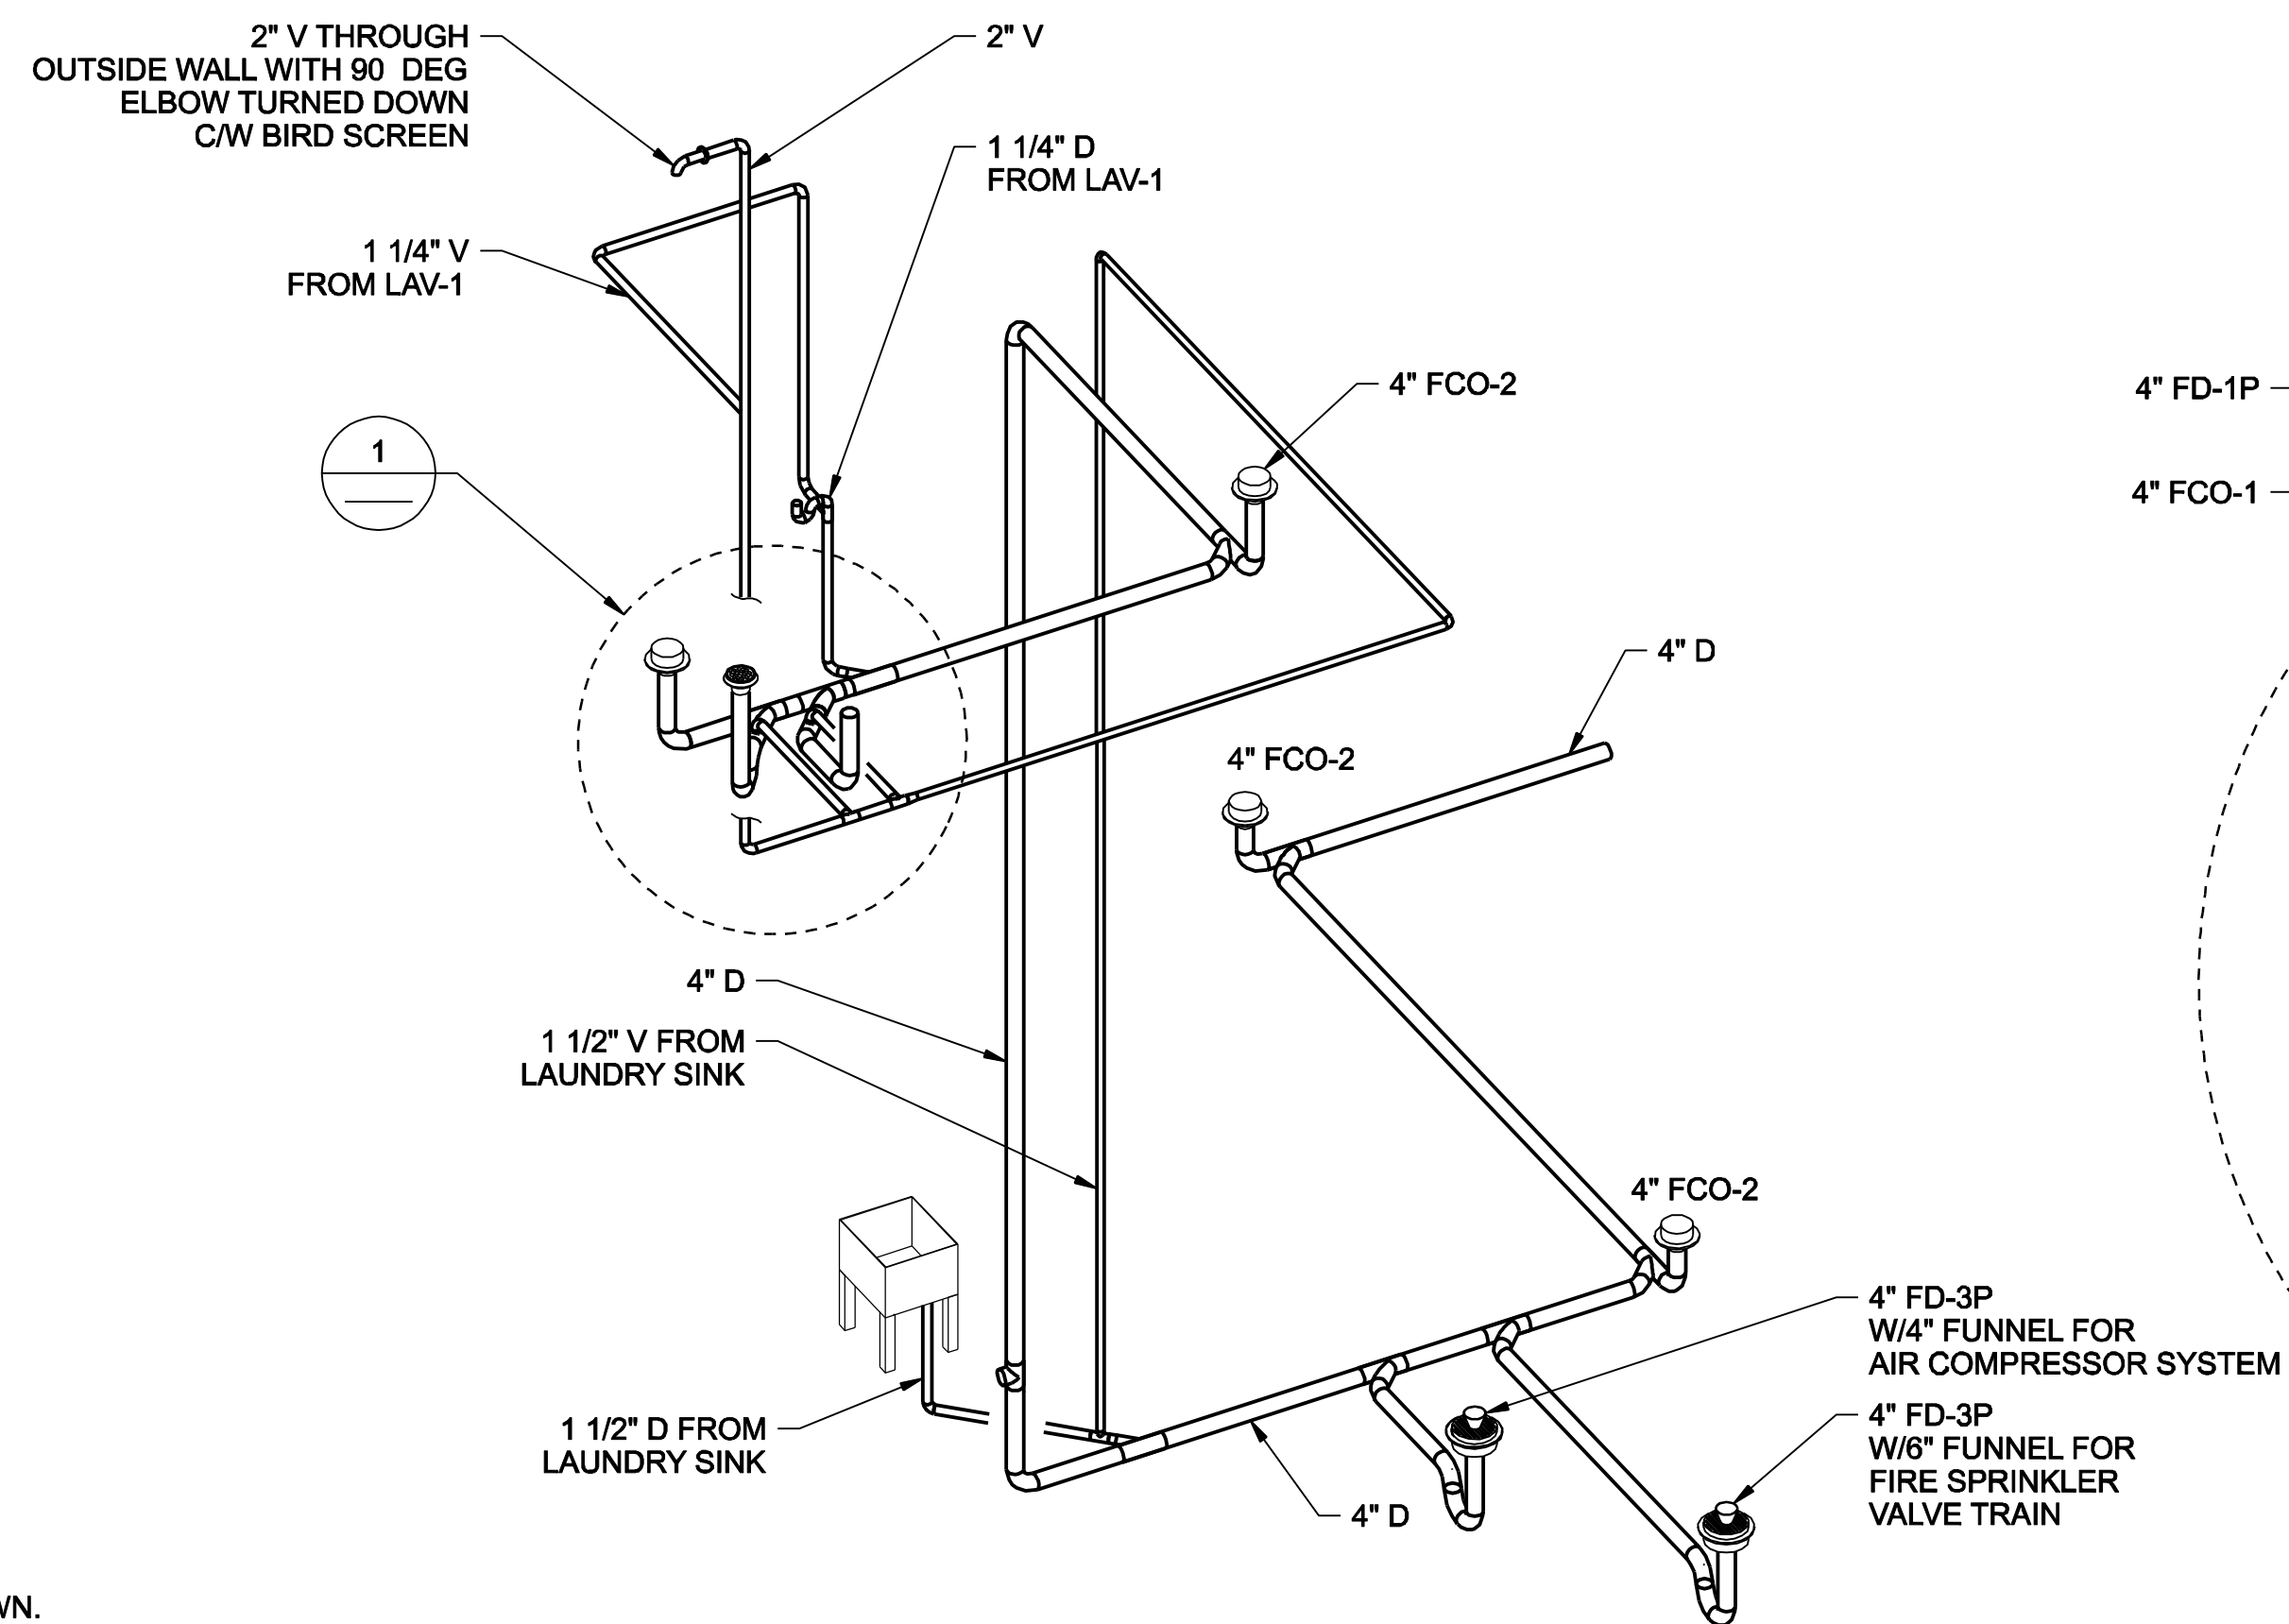

SANITARY DRAINAGE AND VENTING RISER DIAGRAM

NTS

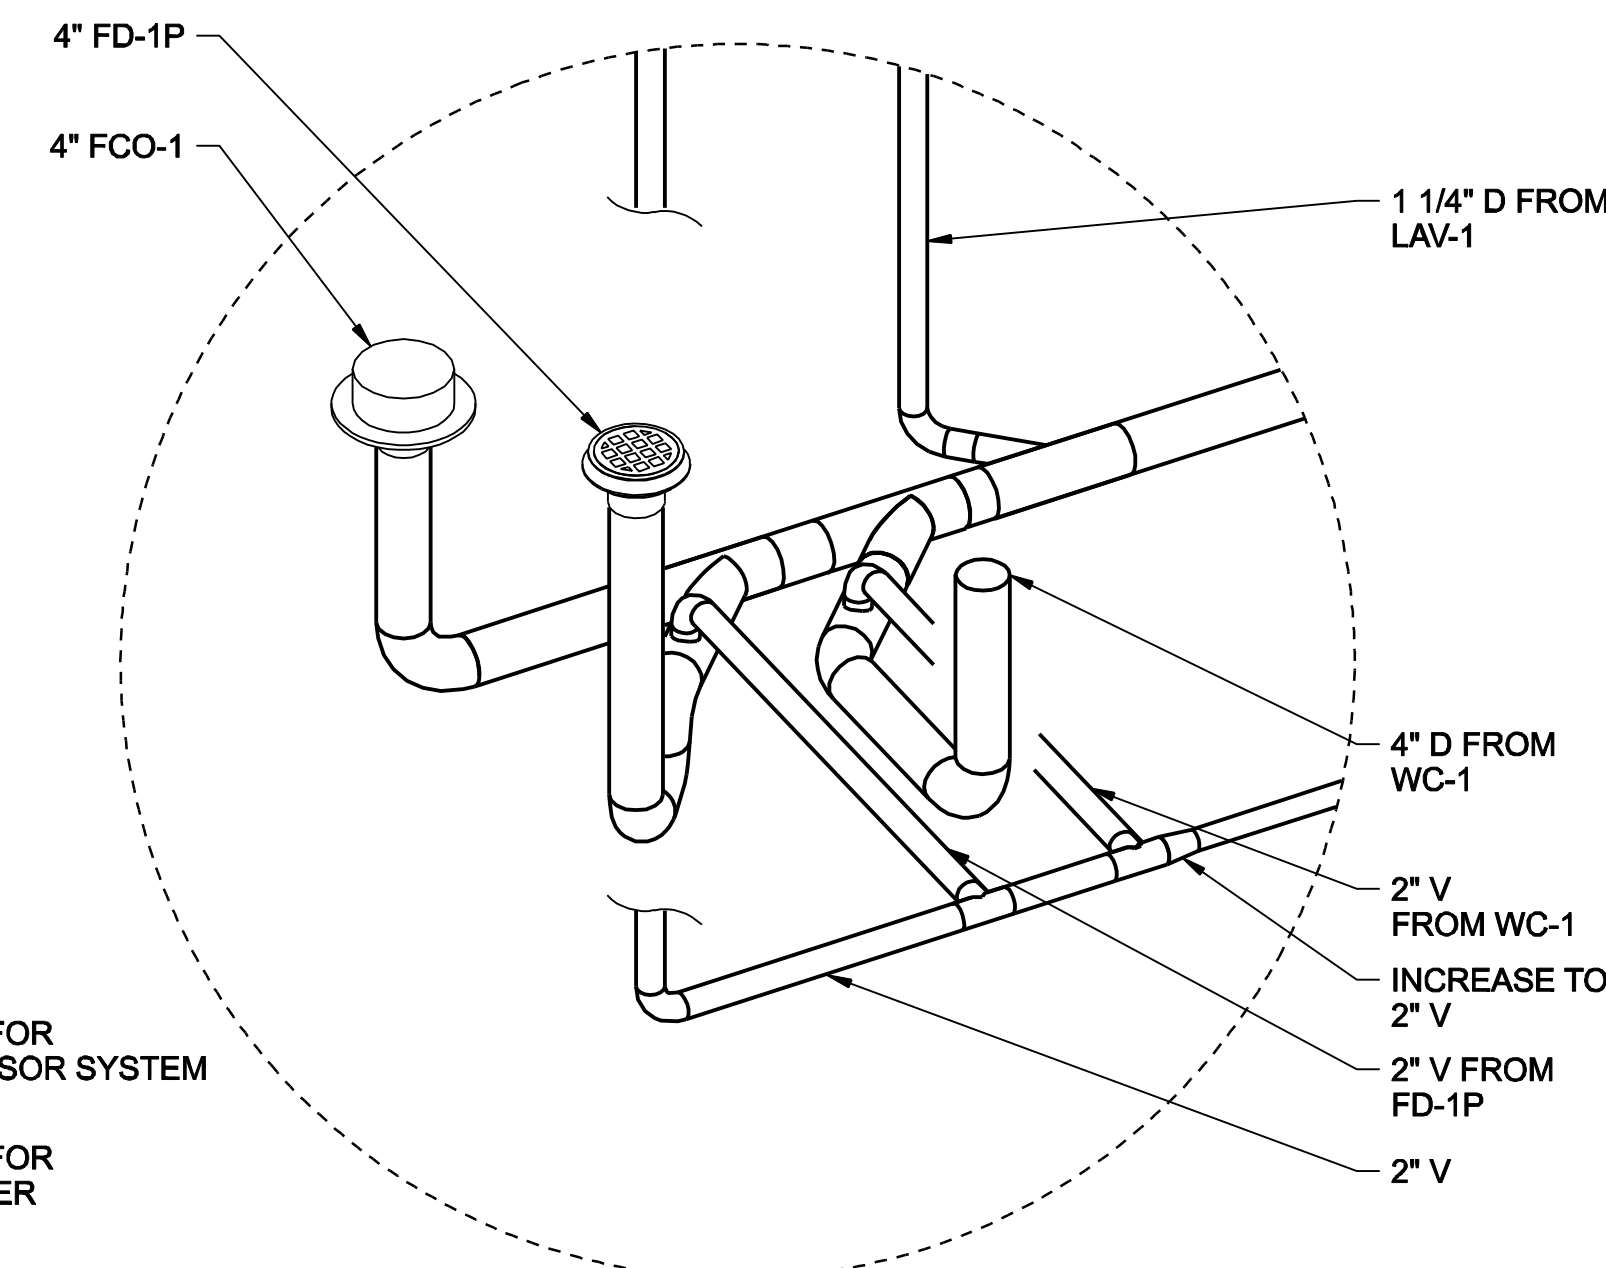

1 WASHROOM

NTS

THESE RECORD DOCUMENTS HAVE BEEN PREPARED BASED ON THE INFORMATION PROVIDED BY OTHERS. THE DESIGN PROFESSIONAL HAS NOT VERIFIED THE ACCURACY AND/OR COMPLETENESS OF THIS INFORMATION AND SHALL NOT BE RESPONSIBLE FOR ANY ERRORS OR OMISSIONS WHICH MAY BE INCORPORATED HEREIN AS A RESULT.



CH2MHILL

STAMFORD WATER POLLUTION CONTROL AUTHORITY SOLIDS DRYING PROJECT

BUILDING SERVICES PLUMBING RISER DIAGRAMS

VERIFY SCALE	
BAR IS ONE INCH ON ORIGINAL DRAWING.	
DATE	JUNE 2006
PROJ	334058
DWG	B-2413
SHEET	B15

01/20/08	DR	S. LAROCQUE	CHK	APVD	B. GACKSTATTER
09/08/06	REVISION	M. RAHMAN	BY	APVD	
07/04/06	REVISION	S. LAROCQUE	BY	APVD	
06/05/06	REVISION	S. LAROCQUE	BY	APVD	
0	REVISION	S. LAROCQUE	BY	APVD	
1	REVISION	S. LAROCQUE	BY	APVD	
2	REVISION	S. LAROCQUE	BY	APVD	
3	REVISION	S. LAROCQUE	BY	APVD	
RECORD DRAWING					
RE-ISSUED FOR CONSTRUCTION					
ISSUED FOR CONSTRUCTION					
FOR FINAL REVIEW/ BUILDING PERMIT					

REUSE OF DOCUMENTS: THIS DOCUMENT AND THE IDEAS AND DESIGNS INCORPORATED HEREIN, AS AN INSTRUMENT OF PROFESSIONAL SERVICE, IS THE PROPERTY OF CH2M HILL AND IS NOT TO BE USED, IN WHOLE OR IN PART, FOR ANY OTHER PROJECT WITHOUT THE WRITTEN AUTHORIZATION OF CH2M HILL. © CH2M HILL 2004. ALL RIGHTS RESERVED.