


- NOTES:**
- PROVIDE 2 PAIR TELEPHONE CABLE FROM THIS OUTLET TO THE EXISTING CENTRAL ANALOG TELEPHONE SYSTEM CONNECTION PANEL IN THE OPERATIONS BUILDING VIA THE EXISTING 2" UNDERGROUND TELEPHONE CONDUIT BETWEEN THE SLUDGE PROCESSING BUILDING AND THE OPERATIONS BUILDING. PROVIDE 3/4" CONDUIT BETWEEN THIS OUTLET AND THE 2" CONDUIT IN THE SLUDGE PROCESSING BUILDING AND INSIDE THE OPERATIONS BUILDING.
 - PROVIDE A DATA (COMMUNICATIONS) CABLE BETWEEN THIS OUTLET BOX AND THE EXISTING CENTRAL COMPUTER SYSTEM IN THE OPERATIONS BUILDING, VIA THE EXISTING 4" UNDERGROUND SCADA CONDUIT BETWEEN THE SLUDGE PROCESSING BUILDING AND THE OPERATIONS BUILDING. PROVIDE 3/4" CONDUIT BETWEEN THIS OUTLET BOX AND THE 4" CONDUIT IN THE SLUDGE PROCESSING BUILDING AND INSIDE THE OPERATIONS BUILDING.
 - EMERGENCY PULL CORD STATION - INSTALL ON THE WALL INSIDE THE WASHROOM, EXTEND PULL-CORD TO FLOOR LEVEL; PROVIDE AND INSTALL NAMEPLATE WITH 1/4" HIGH RED LETTERS ON WHITE BACKGROUND TO READ "PULL CORD FOR EMERGENCY ASSISTANCE" LOCATE AS DIRECTED BY ENGINEER.
 - BUZZER/STROBE FOR EMERGENCY ASSISTANCE. INSTALL 6" ABOVE DOOR HEADER.
 - EMERGENCY ASSISTANCE KIT TO BE EDWARDS CAT NO. 7008B-N5, 120V, CONSISTING OF CAT. NO. 7007B-N5 BUZZER/STROBE AND CAT. NO. 6357 EMERGENCY PULL CORD STATION; PROVIDE WATCHING OUTLET BOXES. CONNECT THE SYSTEM AS PER THE MANUFACTURERS INSTRUCTIONS.
 - GFI RECEPTACLES TO BE MOUNTED ON ROOF NEXT TO HVAC EQUIPMENT AS PER CODE REQUIREMENTS.
 - UPS RECEPTACLE FOR REMOTE WORKSTATION, RECEPTACLE TO BE FED FROM ANDRITZ UPS PANEL BOARD. CONTRACTOR TO PROVIDE AND INSTALL 15A BREAKER AND ALL REQUIRED CONDUIT AND WIRING AND COORDINATE EXACT LOCATION WITH EQUIPMENT SUPPLIER.
 - WASHROOM LIGHT SWITCH TO CONTROL BOTH THE LIGHT AND THE EXHAUST FAN EF424-02.
 - COORDINATE FINAL LOCATIONS OF ALL TYPE 1 FIXTURES WITH DRYER EQUIPMENT. ALL FIXTURES SHALL LOWER TO THE FLOOR WITHOUT INTERFERING WITH DRYER EQUIPMENT. PROVIDE LOWERING DEVICE AS PER DETAIL INCLUDED ON THIS SHEET.
 - TYPE 1 FIXTURE. BOTTOM OF FIXTURE TO BE MOUNTED 33'-0" AFF.

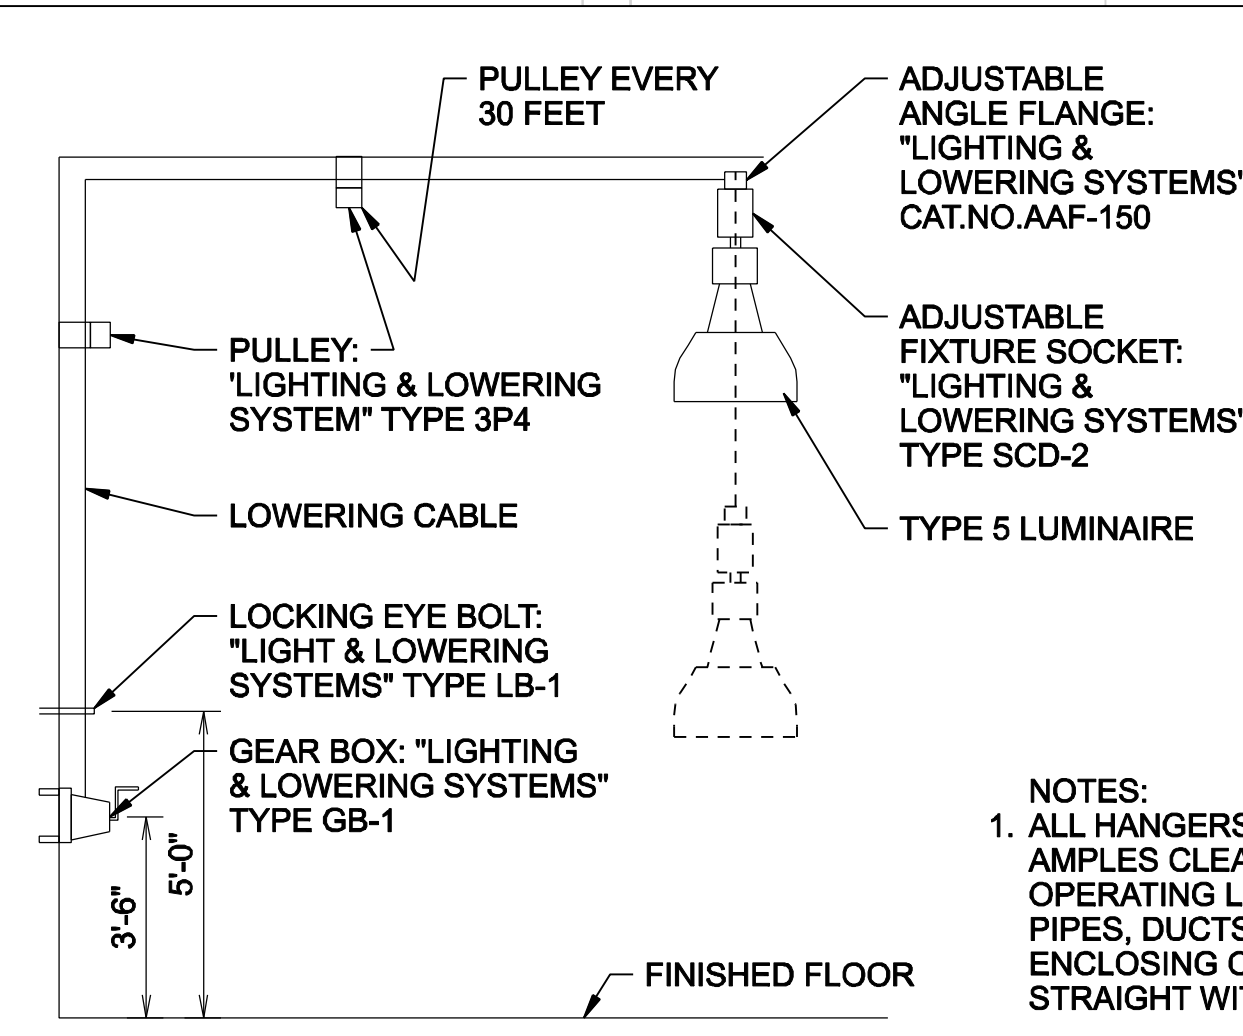

- NOTES:**
- ALL HANGERS MUST BE PLUMB. ALLOW AMPLES CLEARANCE BETWEEN OPERATING LINE STRUCTURAL MEMEBERS, PIPES, DUCTS, ETC. ALL CONDUIT RUNS ENCLOSING OPERATING LINES MUST BE STRAIGHT WITH NO OFFSET BENDS.
 - LIGHT FIXTURE LOWERING SYSTEM TO BE AS MANUFACTURED BY "LIGHT & LOWERING SYSTEM, INC" OR EQUAL.

THIRD FLOOR PLAN

1/4"=1'

FIXTURE TYPES
 TYPE 4 FIXTURE TO BE LITHONIA FPP24 2 32 T1X12 120 GEB LP841

		RECORD DRAWINGS		BY	APVD
		ND	BG	BG	BG
STAMFORD WATER POLLUTION CONTROL AUTHORITY SOLIDS DRYING PROJECT		FIXTURE TYPE HAS BEEN REVISED		BY	APVD
		ND	BG	BG	BG
		ISSUED FOR CONSTRUCTION		BY	APVD
		ND	BG	BG	BG
ELECTRICAL THIRD FLOOR PLAN		FOR FINAL REVIEW/BUILDING PERMIT		BY	APVD
		ND	BG	BG	BG
19/03/08	06/05/06	07/04/06	06/05/06	DR	N. DATOO
4	2	1	0	CHK	B. GACKSTATTER
VERIFY SCALE BAR IS ONE INCH ON ORIGINAL DRAWING.		DATE: JUNE 2006 PROJ: 334058 DWG: E-2403 SHEET: E5			