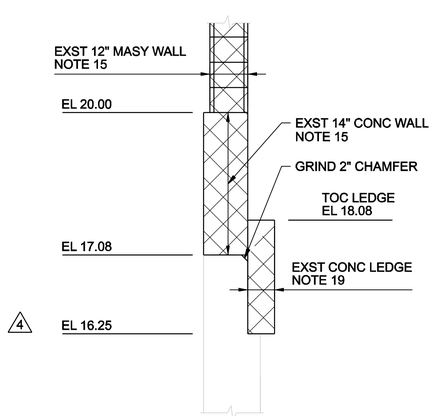

1 DETAIL
NTS

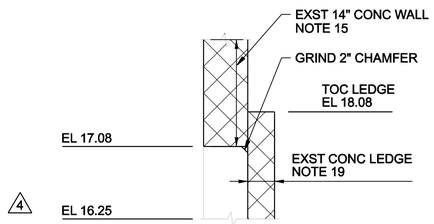

2 DETAIL
NTS

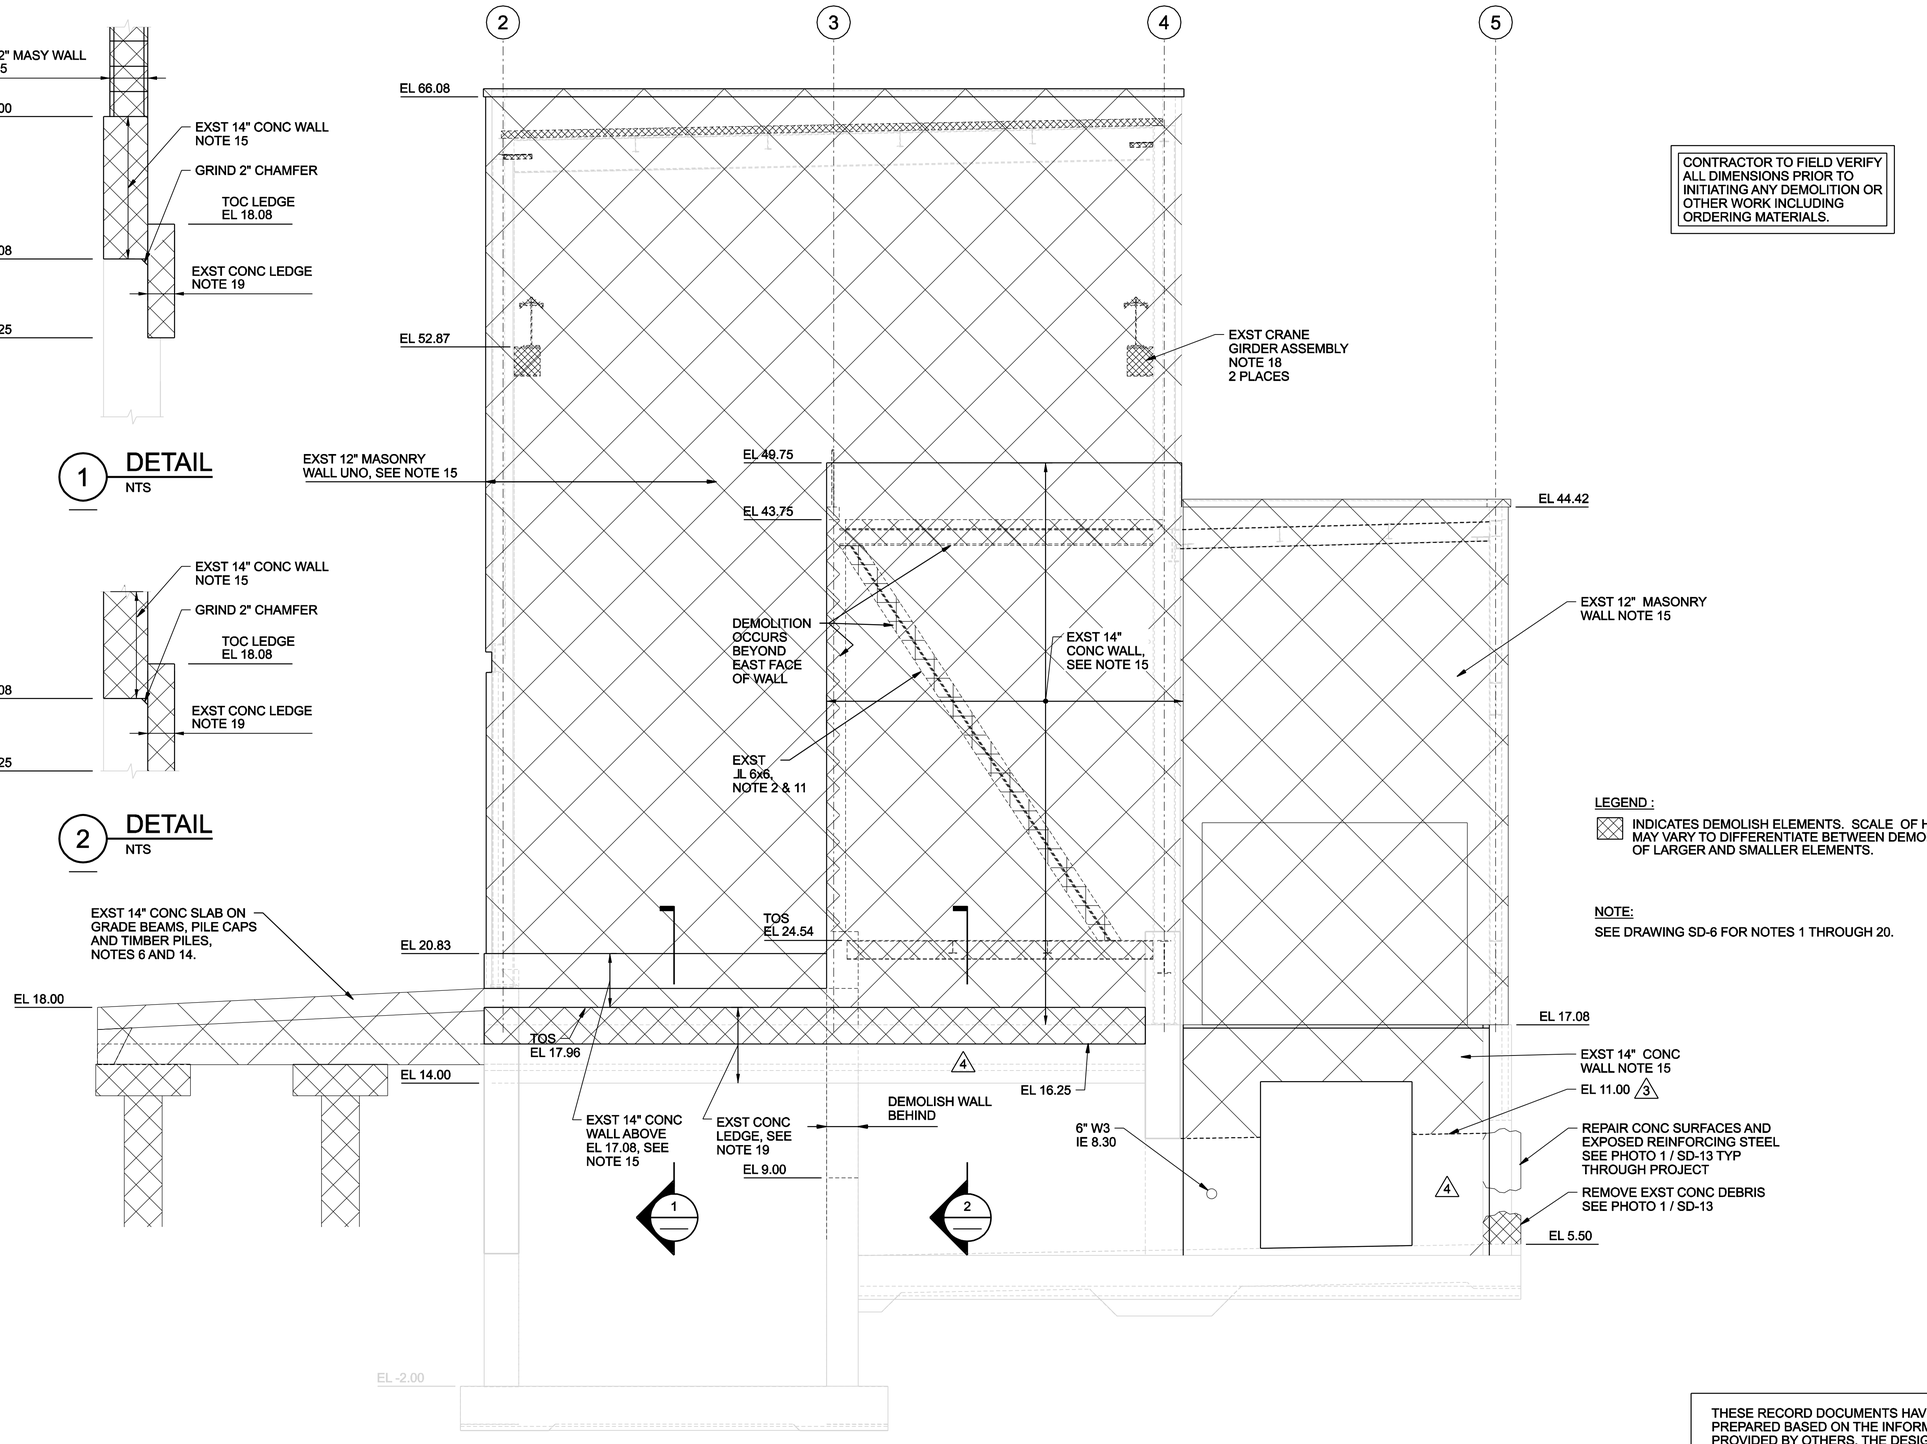

A SECTION
1/4"=1'-0"
SD-4

CONTRACTOR TO FIELD VERIFY ALL DIMENSIONS PRIOR TO INITIATING ANY DEMOLITION OR OTHER WORK INCLUDING ORDERING MATERIALS.

LEGEND :

INDICATES DEMOLISH ELEMENTS. SCALE OF HATCH MAY VARY TO DIFFERENTIATE BETWEEN DEMOLITION OF LARGER AND SMALLER ELEMENTS.

NOTE:

SEE DRAWING SD-6 FOR NOTES 1 THROUGH 20.

THESE RECORD DOCUMENTS HAVE BEEN PREPARED BASED ON THE INFORMATION PROVIDED BY OTHERS. THE DESIGN PROFESSIONAL HAS NOT VERIFIED THE ACCURACY AND/OR COMPLETENESS OF THIS INFORMATION AND SHALL NOT BE RESPONSIBLE FOR ANY ERRORS OR OMISSIONS WHICH MAY BE INCORPORATED HEREIN AS A RESULT.

NO.	DATE	REVISION	DR	CHK	APVD
5	01/20/08	RECORD DRAWING	BG		BG
4	02/05/07	REVISION PER CCIR No.DR-14			
3	01/29/07	REVISION PER CCIR No.DR-12	BG	PW	
2	09/08/06	RE-ISSUED FOR CONSTRUCTION	BG	PW	
1	07/04/06	ISSUED FOR CONSTRUCTION	BG	PW	
0	06/19/06	FOR FINAL REVIEW/ BUILDING PERMIT	MC	BG	
DSGN	M. CHRZANOWSKI		A. CHADHA	M. GOODSON	B. GACKSTATTER

STAMFORD WATER POLLUTION CONTROL AUTHORITY
SOLIDS DRYING PROJECT

CH2MHILL

STRUCTURAL

DEMOLITION SECTION ALONG COLUMN LINE A

VERIFY SCALE

BAR IS ONE INCH ON ORIGINAL DRAWING.
0 1"

DATE	JUNE 2006
PROJ	334058
DWG	SD-7
SHEET	S6

FILENAME: std007_334058.dgn MODIFIED DATE: MODIFIED TIME:

REUSE OF DOCUMENTS: THIS DOCUMENT, AND THE IDEAS AND DESIGNS INCORPORATED HEREIN, AS AN INSTRUMENT OF PROFESSIONAL SERVICE, IS THE PROPERTY OF CH2M HILL AND IS NOT TO BE USED, IN WHOLE OR IN PART, FOR ANY OTHER PROJECT WITHOUT THE WRITTEN AUTHORIZATION OF CH2MHILL.
©CH2M HILL 2004. ALL RIGHTS RESERVED.