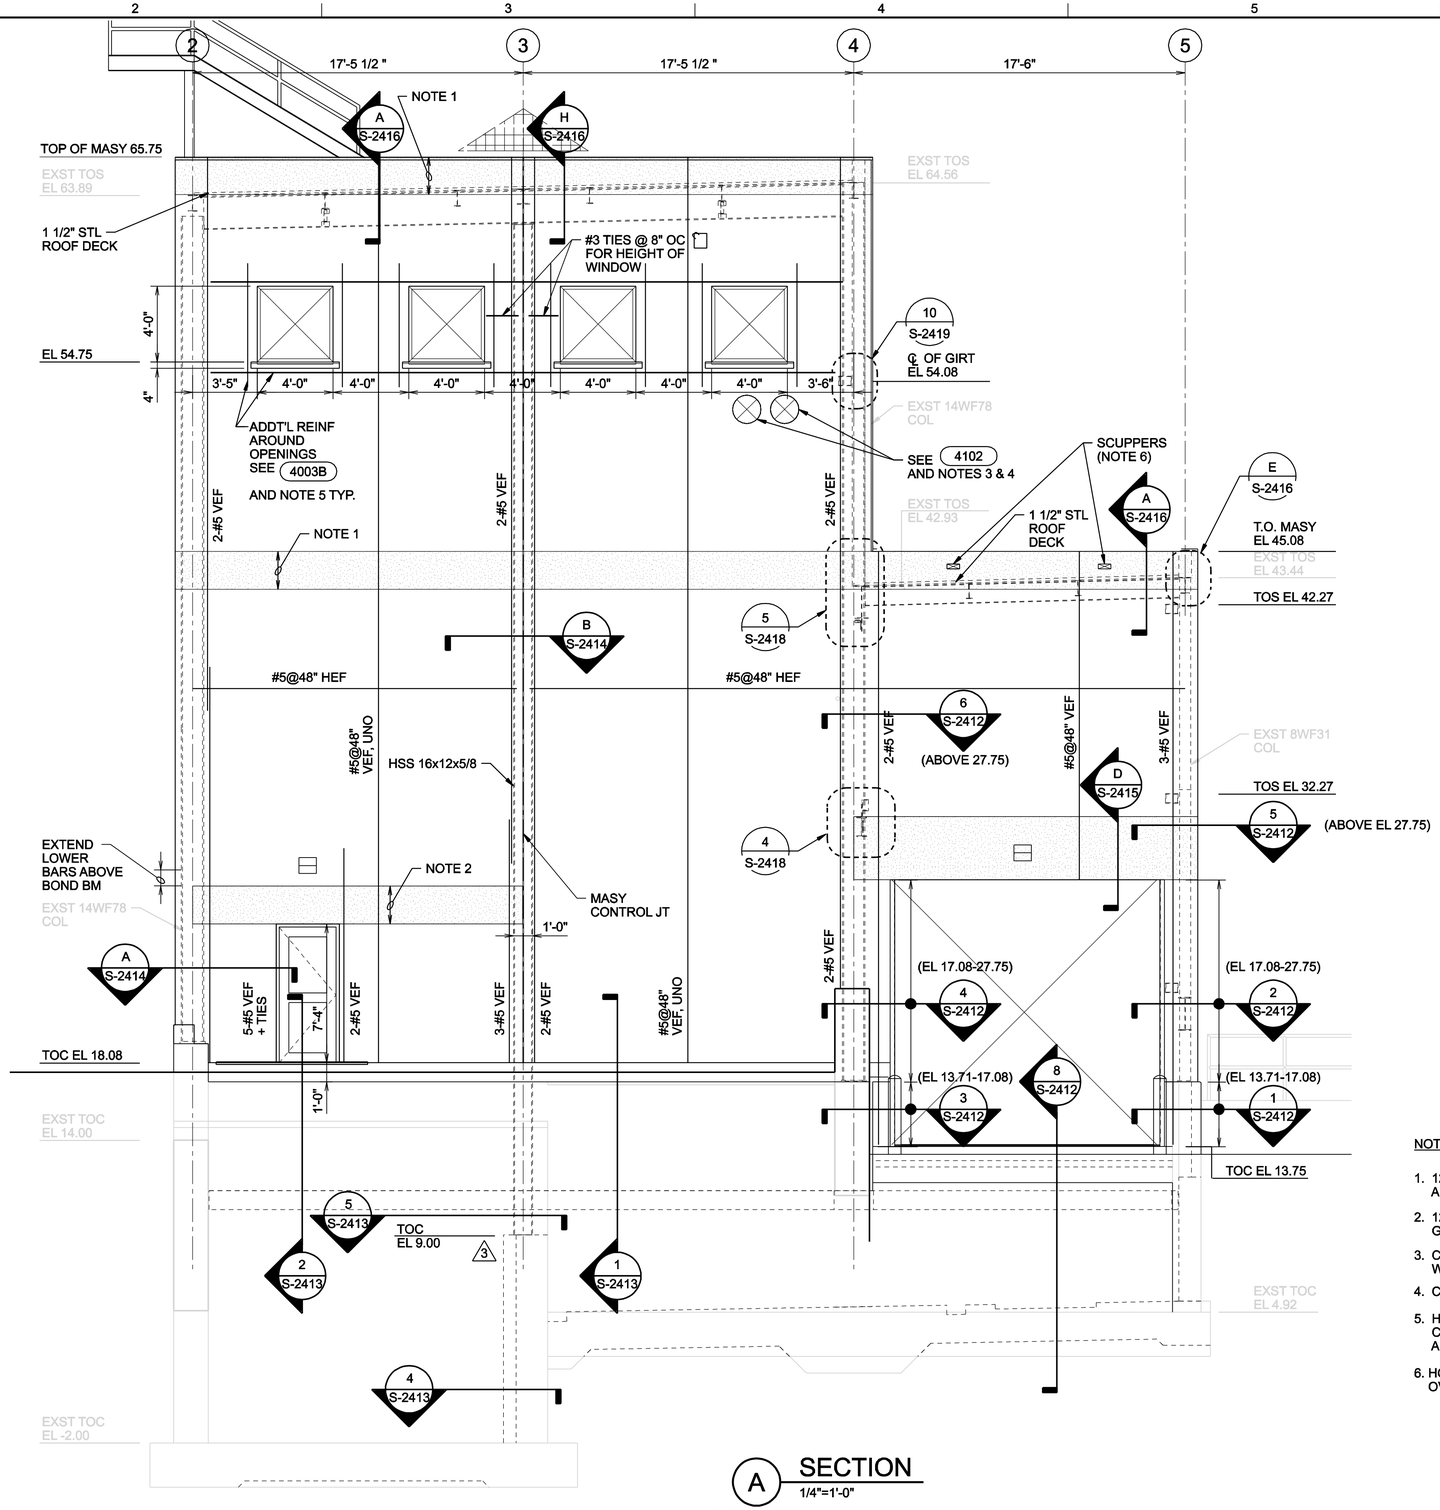

A SECTION
1/4"=1'-0"
S-2400, S-2401
S-2402, S-2414, S-2415

CONTRACTOR TO FIELD VERIFY ALL DIMENSIONS PRIOR TO INITIATING ANY DEMOLITION OR OTHER WORK INCLUDING ORDERING MATERIALS.

NOTES:

1. 12"x24" MIN BOND BEAM REINFORCED WITH 2-#5 TOP AND BOTTOM, CONTINUOUS ENTIRE LENGTH OF WALL.
2. 12"x24" BOND BEAM REINFORCED WITH 3-#5 HEF FROM GRIDS ② TO ③ .
3. COORINATE SIZE AND LOCATION OF PENETRATION WITH EQUIPMENT MANUFACTURER.
4. CAST SLEEVE IN WALL INSTEAD OF CORING.
5. HORIZ REINF ABOVE & BELOW OPENINGS TO BE CONTINUOUS BETWEEN BUILDING COLUMNS 2 TO 3 AND 3 TO 4.
6. HORIZ REINF AT TOP OF WALL TO BE CONTINUOUS OVER SCUPPER USING U-SHAPED LINTEL BLOCKS.

THESE RECORD DOCUMENTS HAVE BEEN PREPARED BASED ON THE INFORMATION PROVIDED BY OTHERS. THE DESIGN PROFESSIONAL HAS NOT VERIFIED THE ACCURACY AND/OR COMPLETENESS OF THIS INFORMATION AND SHALL NOT BE RESPONSIBLE FOR ANY ERRORS OR OMISSIONS WHICH MAY BE INCORPORATED HEREIN AS A RESULT.

NO.	DATE	REVISION	BY	APVD
4	01/20/08	RECORD DRAWING	BG	BG
3	09/19/06	REVISION PER RFI No.DR-7	BG	PW
2	09/08/06	RE-ISSUED FOR CONSTRUCTION	BG	PW
1	07/04/06	ISSUED FOR CONSTRUCTION	MC	BG
0	06/19/06	FOR FINAL REVIEW/ BUILDING PERMIT	BY	APVD

DSGN M. CHRZANOWSKI DR G. OMORI CHK M. GOODSON APVD B. GACKSTATTER

STAMFORD WATER POLLUTION CONTROL AUTHORITY
SOLIDS DRYING PROJECT

CH2MHILL

STRUCTURAL
SECTION

VERIFY SCALE
BAR IS ONE INCH ON ORIGINAL DRAWING.
0 1"

DATE	JUNE 2006
PROJ	334058
DWG	S-2403
SHEET	S16

REUSE OF DOCUMENTS: THIS DOCUMENT, AND THE IDEAS AND DESIGNS INCORPORATED HEREIN, AS AN INSTRUMENT OF PROFESSIONAL SERVICE, IS THE PROPERTY OF CH2M HILL AND IS NOT TO BE USED, IN WHOLE OR IN PART, FOR ANY OTHER PROJECT WITHOUT THE WRITTEN AUTHORIZATION OF CH2MHILL.
© CH2M HILL 2004. ALL RIGHTS RESERVED.

FILENAME: sts2403_334058.dgn MODIFIED DATE: MODIFIED TIME: